


Section 14 Township 15 Range 13W

Well No. #3 Kejr "A"

Company Shell

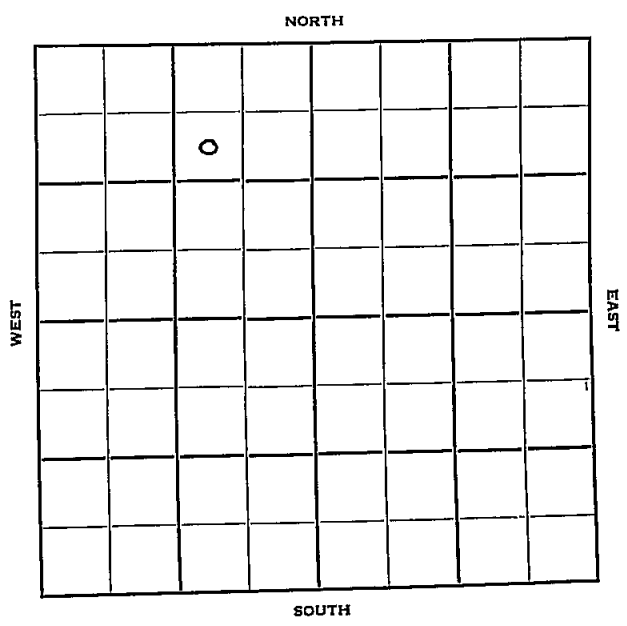

Sec. 14 Twp. 15 R. 13W

Well No. #3 Kejr-"A" Farm

Shell

Company

Contractor

Ely Pool


990' Ft. from N. Line

Ft. from S. Line

990' Ft. from E. Line

Ft. from W. Line

SW NE NW

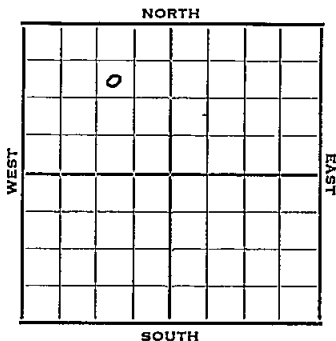

1952

Elev. 1796'

REPORT

2/20

Location

3/5

Torkio 2391'

Topeka 2662'

Tor. 2917'

Br. 11 2978'

Lans. KC 2993'

Drlg. 3272'

3/11

Arb. 3267 TD 3297 Sch.

5" @ 3296 PB 3251 116/ 3143-72

B/ 2 gal oil 5 hrs. Sch. tops:

Topeka 2664

Torkio 2917

Lans KC 2992

Arb. 3263

3/19

3000 A P/1½ BO & 8-¾ BW 10 hrs.

3/25

PB 2950 52/ 2917-30 Test

SSO & W 3000 A P/ 78 BO

& 5 BW 24 hrs.

4/1

Temp. P/ 7½ BO 4 hrs. POP

4/9

"

4/23

NR

4/30

"

5/7

NR

5/14

"

5/21

"

5/28

"

6/11

g

6/18

"

OVER

1952

6/25

Spud 2-23-52

Oil Well TD 3297 8" @ 303

Añhý 755

Tár 2391

Top. 2664

Tor. 2917

Br Li 2978

Lans. 2992

Arb. 3263

TD 3297 5" @ 3296 PB 3251

116/ 3143-3172 B/ 2 bo 5 hr.

3000 A P/ $1\frac{1}{2}$ bo 8- $\frac{3}{4}$ " bw 10 hr.

PB 2950 52/ 2917-30 SSO & W

3000 A P. 78 bo 5 bw 24 hr.

P. $7\frac{1}{2}$ bo 4 hr.

Comp. 22 bopd 1 bw

COMPLETED

