

Section 14 Township 15 Range 13 W

Well No. # 2 Kejr (A)

Company Shell Oil

NORTH

	0						

WEST

EAST

SOUTH

Sec. 14 Twp. 15 R. 13W

Well No. #2 Kejr (A) Farm

Shell Oil Company

K & E - Contr. Contractor

Ely Pool


330' Ft. from N. Line

\_\_\_\_\_ Ft. from S. Line

\_\_\_\_\_ Ft. from E. Line

330' Ft. from W. Line

NW NW NW

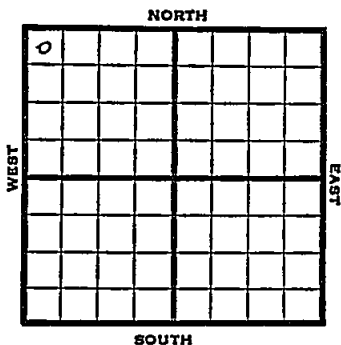

1951 Elev. 1820' REPORT

6/27 Spud 6-22-51  
10" @ 774  
Drlg. 1510'

8/15 Spud 6-22-51 Oil well TD 3321'  
10" @ 774' Tarkio 2417' Top 2694'  
Tor. 2944' Br. line 3006' KC 3021'  
7" @ 3320' Arb. 3292' TD 3321'  
24/3040-46 1000 A S/45 BW  
B/30 GWPH 2000 A B/4 BO 1 BWPH  
SP 3031' 18/3018-24 1000 A  
B/4 GO 8 GW 1/2 hr. PB 2996'  
64/2942-58 B/3 1/2 GO 94 GWPH  
4000 A S/2 BO 2 1/2 BWPH  
Comp. 41 BOPD 78 BW

COMPLETED

County Russell State Kansas

Sec. 14 (Blk. Twp.) 15 (Sur. Rge.) 1SW Map No.

Operator Shell Oil

Well No. 2 Farm Kejr (A)

Elev. Location NW NW NW

6					
FIRST REPORT					

330 Ft. From N Line NW

330 Ft. From W Line Quarter

1st. Report JUN 27 1951

Completion

Remarks

K&E - Contr.

Spudding Date 6-22-51

Drlg. Data Ely Foot

10" @ 774 Drlg. 1510

J. E. TYRA

County Russell State KansasSec. 14 (Bk.  
Twp.) 15 (Sur.  
Rge.) 13W Map No.Operator Shell OilWell No. 2 Farm Kejr "A"Elev. 1820 Location NW NW NW

0					

COMPLETE

330 Ft. From N Line NW330 Ft. From W Line Quarter

1st. Report

Completion AUG 15 1951Remarks Ely PoolK & E Drlg. - Contr.Spudding Date 6-22-51Drlg. Data Oil well TD 332110" @ 774 Tarkio 2417 Top. 2694Tor. 2944 Br. lime 3006 KC 30217" @ 3320 Arb. 3292 TD 332124/ 3040-46 1000 A S/ 45 bwB/ 30 gwph 2000 A B/  $\frac{1}{4}$  bo 1 bwphSP 3031 18/ 3018-24 1000 A B/ 4 go8 gw  $\frac{1}{2}$  hr. PB 2996 64/ 2942-58B/  $3\frac{1}{2}$  go 94 gwph 4000 A S/ 2 bo  $2\frac{1}{2}$  bwph Comp. 41 bopd 78 bw

J. E. TYRA