


Barton

KANSAS

SECTION 27 TOWNSHIP 16 RANGE 12W

WELL NO. #3 McLaughlin

COMPANY Duke Drlg.

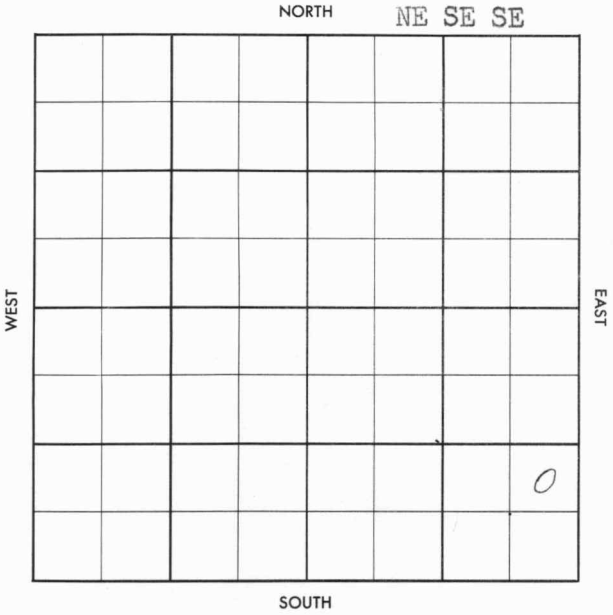

County Barton Elev. 1900  
 Sec. 27 Twp. 16 Rge. 12W  
 Company Duke Drlg.  
 Farm Name McLaughlin No. 3

TOPS	DEPTH	LOG	DATUM	Loc. in Sec.
Anh.	779			NE SE SE
TP.				
H.				
Tr.				
Dg.				
Bl.				
L.				Geol.
K.C.				Contr.
B.K.C.				Co. tools
Ce.				
C.				Pool
M.				S. Beaver
M.				
K.				
Mz.				
Mq.				
V.				
S.				
S.				
A.				
R.				
PE.				
G.				
TD.				

FIRST REPORT  
 JAN 23 '57

Date Comm. 1-17-57  
8" @ 300 drlg. 2700

13

Co.  
 Sec.  
 No.  
 Sec.  
 T.  
 R.

County Ranton Elev. 1900  
 Sec. 27 Twp. 16 Rgs. 12W  
 Company Duke Oil Co.  
 Farm Name McLaughlin No. 3

TOPS	DEPTH	LOG	DATUM
Anh.	779		
T.P.			
H.	2983		
Tr.			
Dg.			
Bl.	3076		
L.	3090		
K.C.			
B.K.C.			
Ce.			
C.			
M.			
M.			
K.			
Mz.			
Me.			
V.			
S.			
S.			
A	3359		
R.			
PE.			
G.			
T.D.	3421/2		

Loc. in Sec. NE SE SE  
 Geol. \_\_\_\_\_  
 Contr. \_\_\_\_\_  
 Co. tools \_\_\_\_\_  
 Pool \_\_\_\_\_  
S. Beaver

**ABANDONED**  
 APR 24 '57

Date Comm. 1-17-57  
8" @ 300 drlg. 2700 JAN 20 '57 5 1/2  
@ 3418 (To be SWD) FEB 6 '57  
W.O.O. FEB 13 '57 FEB 20 '57 FEB 27 '57 MAR 5 '57  
MAR 13 '57 MAR 20 '57 X WOCT MAR 27 '57 ✓  
To be SWD APR 3 '57 APR 10 '57 APR 17 '57  
APR 24 '57 DI 3435 IN. INPUT 240  
Bwph  
corr. for SWD well

Co.  
 Use  
 No.  
 Sec.  
 T.  
 R