


Section 14 Township 15 Range 13WWell No. 1 - KejrCompany Duke & Wood

NORTH

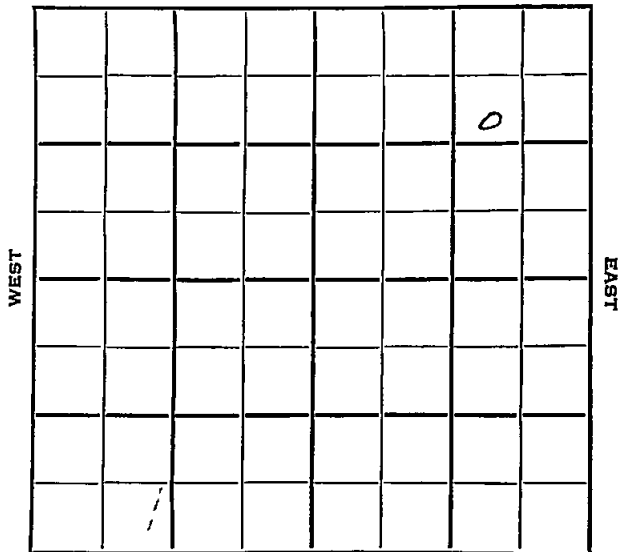

SOUTH

Russell

KANSAS ✓

Sec. 14 Twp. 15 R. 13 WWell No. # 1 Kejr Farm

Duke & Wood

Company

Trapp Pool

Contractor

800

Ft. from N. Line


Ft. from S. Line

990

Ft. from E. Line

Ft. from W. Line

SW NE NE

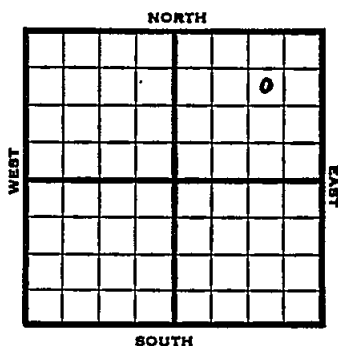

1952

Elev. 1775'

REPORT

12/30

Drlg.

1/8

Drlg. 270 Tarkio 2364 Heeb 2870 Br1
 2948 Lans 2963 DST 2954-77 1 Hr.
 58' D & GCM 10' Hly 0 & GCM 60'
 Gossy oil 720# DST 2989-3026 1 Hr.
 105' SO&GCM 60' Hlg 0 & GCM 60' Oil
 350# Cong 3237 RTD 3253 5" @ 3252

1/22

CO 3234' 23/3138-43 500 A
 S/6 BO plus 1/2 BW ~~XXXX~~ 2000 A
 S/82 BO plus 55 BW 1 hr. PB 3062
 12/3020-23 5 GO plus 1 GW

1/29

NR

2/5

NR

2/11

Spud 12-14-52

Oil Well

TD3253

8" @ 270

Tarkio 2364, Heeb 2870, Br lime
 2948, Lans 2963

DST 2954-77, opn 1 hr., rec.

58' o & gcm, 60' ho & gcm, 60'
 gassy oil, 720#

DST 2989-3026, opn 1 hr., rec.

105' so & gcm, 60' ho & gcm,
 60' oil, 350#

Cong 3237

TD 3253

OVER

#1 Kejr
(Information Brought Forward)

1953
2/11

5" @ 3252
CO to 3234
23/3138-43, 500A
S/6 bo $\frac{1}{2}$ bw 2000A
S/82 bo 55 bw 1 hr.
PB 3062
12/3020-23, 5 go 1 gw
Comp. 240 bopd

COMPLETED


J. G. McGEHEE

County Russell State Kansas
 Sec. 14 (Blk.) 15 (Sur.) 13W Map No.

Operator Duke & Wood

Well No. 1 Farm Kejr

Elev. 1775 Location SW NE NE

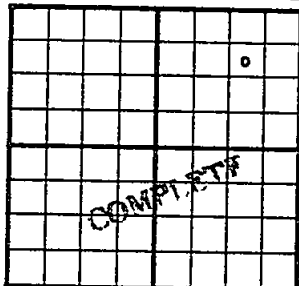

800 Ft. From N Line NE

990 Ft. From E Line Quarter

1st. Report

Completion FEB 11 1953

Remarks Trapp Pool

Spudding Date 12-14-52

Drlg. Data Oil well TD 3253

8" @ 270 Tarkio 2364 Heeb. 2870

Br. lime 2948 Lans. 2963 DST 2954-77

open 1 hr. Rec. 58' o & gcm 60' ho & gcm

60' gassy oil 720# DST. 2989-3026

open 1 hr. Rec. 105' so & gcm 60' ho & gcm

60' oil 350# Cong. 3237 TD 3253

5" @ 3252 CO to 3234 23/23138-43

500 A S/ 6 bo 1/2 bw 2000 A S/ 82 bo

55 bw 1 hr. PB 3062 12/ 3020-23

5 go 1 gw Comp. 246 bopd on M cons