

Russell KANSAS

Section 13 Township 15 Range 13 WWell No. # 1 BerrickCompany B & R Drlg.

NORTH

WEST

EAST

SOUTH

Russell

KANSAS ✓

Sec. 13 Twp. 15 R. 13WWell No. #1 Berrick FarmB & R Drlg.

Company

B & R Drlg.

Contractor

Wildcat.330

Ft. from N. Line


Ft. from S. Line

Ft. from E. Line

330

Ft. from W. Line

NW NW NW

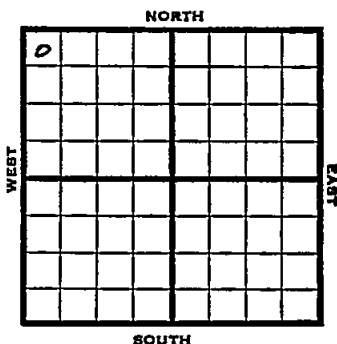

1953

Elev. 1765' REPORT

7/1

Spud 6-26-53

8" @ 287'

Drlg 1500'

7/8

Top 2654, Heeb 2894, Doug 2928, Lans 2986

Drlg 3171'

7/15

Spud 6-26-53 D & A TD 3378

8" @ 287' Top. 2654 Heeb 2894

Doug. 2928 Lans 2986 Cong 3216

Arb. 3340 TD 3378

D & A

ABANDONED.

County Russell State Kansas
 Sec. 13 (Blk.) 15 (Sur.) 13W Map No.
 Operator B & R Drlg.
 Well No. 1 Farm Berrick
 Elev. _____ Location NW NW NW

•							

FIRST REPORT

330 Ft. From N Line NW
330 Ft. From W Line Quarter
 Ist. Report JUL 1 1953

Completion _____

Remarks _____


B & R Drlg. - Contr.

Spudding Date 6-26-53

Drlg. Data Wildcat

8" @ 287 drlg. 1500

County Russell State Kansas
 Sec. 13 (Blk. 15 (Sur. 13W Map No.
 (Twp.) (Rge.)
 Operator B & RIDrlg.
 Well No. 1 Farm Berrick
 Elev. 1765 Location NW NW NW

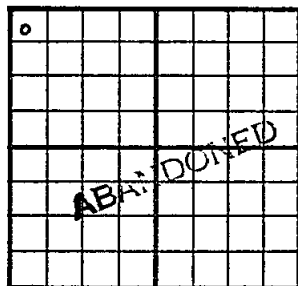

330 Ft. From N Line NW
330 Ft. From W Line Quarter

1st. Report

Completion JUL 15 1953

Remarks Wildcat
B & R Drlg. - Contr.

Spudding Date 6-26-53

Drig. Data D & A TD 3378

8" @ 287 Top. 2654 Heeb. 2894

Doug. 2928 Lans. 2986 Cong. 3216

Arb. 3340 TD 3378

D & A