

KANSAS

Section 13 Township 15 Range 13WWell No. 1 BerrickCompany Shell
Trapp

NORTH

WEST

EAST

							0

SOUTH

Russell

KANSAS

Sec. 13 Twp. 15 R. 13W ✓

Well No. #1 Berrick Farm
Shell Company

Trapp Pool (Kiowa Drlg., Cont.)

NORTH


350' Ft. from N. Line

Ft. from S. Line

350' Ft. from E. Line

Ft. from W. Line

NE/C

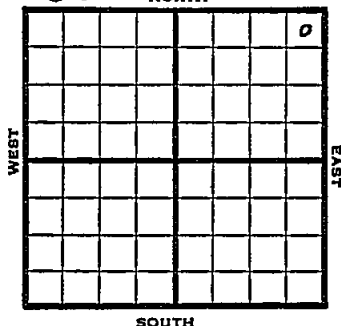

1949

Elev 1804'

R E P O R T

6/15

Location

6/21

8" @ 755'

Drlg 985'

6/28

Drlg 2730'

7/6

Lansing 2969'

Arbuckle 3313'

TD 3314'

4" @ 3312'

7/12

24 shots 3040-46

1000 acid

Flow 28 bbls oil PH

7/20

"

7/27

"

8/3

Flow 25 bbls oil 2 hrs.

8/10

TD 3314'

Lans ng 2969'

Arb. 3313'

4" @ 3312

Perf Lans

1000 acid

Bomb Pot 2964 oil

40⁹ Gr.

Comp

COMPLETED

Russell County Kansas State

Map No. _____ Sec. 13 Twp. 15 R. 13W

Well No. 1 Berrick

Shell Company

Kiowa Drlg. Contractor

NE/C


FIRST REPORT SECTION PLAT

350 Ft. from N. Line

_____ Ft. from S. Line

350 Ft. from E. Line

_____ Ft. from W. Line

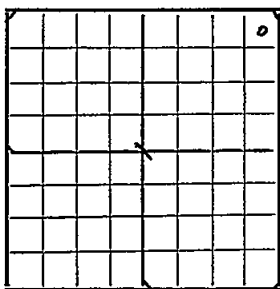

Trapp Pool

Remarks:

Loc

Date
JUN 15 1949

Scout
S. J. LEWIS

Kansas

Map No. K 23 Sec. 13 Twp. 15 R. 13WWell No. 1 BerrickSnell

Company

COMPLETE

Contractor

NE/C

E. 1. 1804

SECTION PLAT

350

Ft. from N. Line

Ft. from S. Line

350

Ft. from E. Line

Ft. from W. Line

			o

Russell County

RECORD

Location

Cased _____ in., _____ ft.

Rig up

Sand

Drilling and Remarks:

Gas

Oil

Total Depth 3014

PRODUCTION

1st 24 hrs. Nat.

1st 24 hrs. after shot

Gas _____ Cu. Ft.

Dry Hole

Abandoned

Loss 2969Acid 33134" 63912Prof. Loss.1000 acidLoss of 29644514

Date

AUG 10 1949

19

S. J. LEWIS

Scout