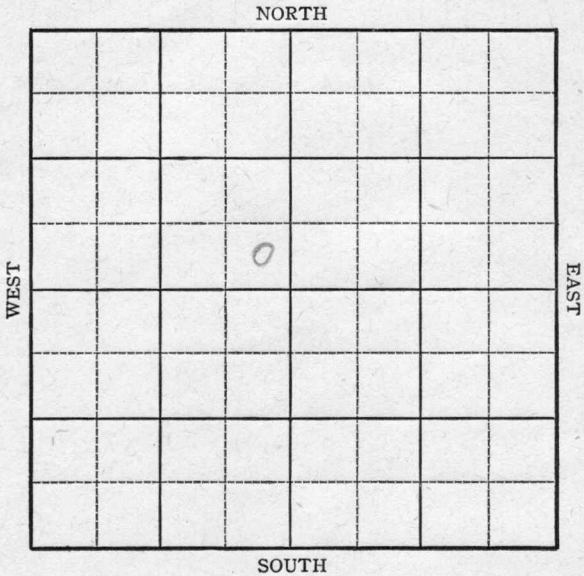


KANSAS

Barton County

FORM 51 5M PETROL

Section 27 Township 16 Range 12WWell No. #1 RiemannCompany C. E. Ash

KANSAS

Sec. 27 Twp. 16 R. 12WWell No. 1 Riemann FarmC. E. Ash Company

Kraft-Prusa

Ft. from N. Line


330

Ft. from S. Line

330

Ft. from E. Line

Ft. from W. Line

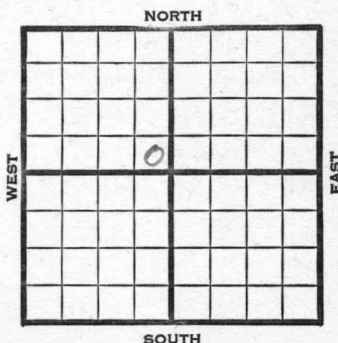

SE NW

Elev. 1899

1945

REPORT

	Location
6/27	RUR
7/3	8" @ 300
7/11	Anhy 785
	Drlg. 830'
7/19	Drlg. 2735
7/26	Lans 3090
	Cong 3352
	Arb. 3353-3363
	TD 3363
	5" @ 3355 RUST
8/1	1200' oil 12 hrs.
8/8	TD 3364
	10 qts. 500 acid.
	Swab 15 oil per hr.
8/15	" " " "
8/22	" " " "
8/29	" " " "
9/5	" " " "
9/12	" " " "
9/19	" " " "
9/26	" " " "
10/3	" " " "
10/10	" " " "
10/17	Arb. 3353
	5" @ 3355
	10 qts. 500 acid.
	TD 3364
	Pump 349 Pot.
	Grav. 41.0

COMPLETED

Kansas Pool Name Kraft-PrusaMap No. 55 Sec. 27 Twp. 16 R. 12WWell No. 1 RiemannC. E. Ash


Company

FIRST REPORT

Contractor

SE NW

SECTION PLAT

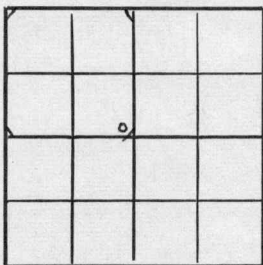

_____ Ft. from N. Line

330 Ft. from S. Line330 Ft. from E. Line

_____ Ft. from W. Line

Barton CountyLocation X

Rig up _____

Drilling and Remarks:

RECORD

Cased _____ in., _____ ft.

Sand _____

Gas _____

Oil _____

Total Depth _____

PRODUCTION

1st 24 hrs. Nat. _____

1st 24 hrs. after shot _____

Gas _____ Cu. Ft.

Dry Hole _____

Abandoned _____

Date

JUN 27 1945 19S. J. LEWIS

Scout

KANSAS

Kansas

Pool Name BeaverMap No. 55 Sec. 27 Twp. 16 R. 12WWell No. 1 Riemann


C. E. Ash

Company

COMPLETED

Contractor

SE NW

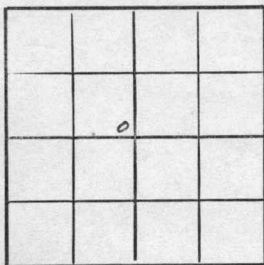E 1/8 1889
SECTION PLAT

Ft. from N. Line

330 Ft. from S. Line330 Ft. from E. Line

Ft. from W. Line

Barton County

Location

Rig up

Drilling and Remarks:

Cr 83355' @ 3305109 to500 equalPump 34941 = Gr

RECORD

Cased _____ in., _____ ft.

Sand _____

Gas _____

Oil _____

Total Depth 3364

PRODUCTION

1st 24 hrs. Nat. _____

1st 24 hrs. after shot _____

Gas _____ Cu. Ft.

Dry Hole _____

Abandoned _____

Date

OCT 17 1945

19

S. J. LEWIS

Scout