

Barton


KANSAS

SECTION 27 TOWNSHIP 16 RANGE 12W

WELL NO. #1 Penka

COMPANY Shields Oil Prod.

NORTH

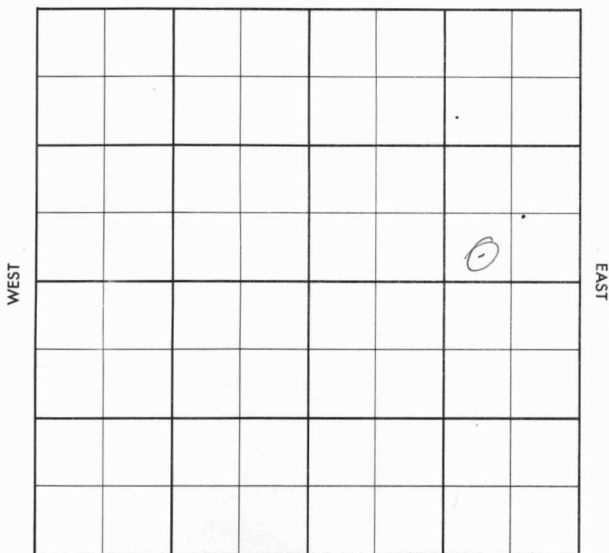

SOUTH

WEST

EAST

Barton

KANSAS

SEC.	TWP.	R.
27	16	12W

WELL NO. #1 Penka FARM

COMPANY Shields Oil Prod

CONTRACTOR Duke Drlg Tools


Kraft-Prusa

_____ FT. FROM N. LINE

_____ FT. FROM S. LINE

_____ FT. FROM E. LINE

_____ FT. FROM W. LINE

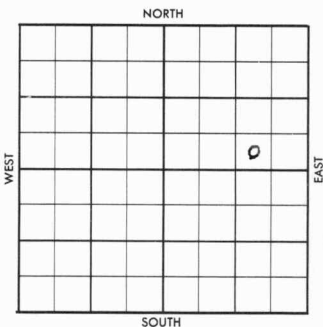

SW SE NE

1956	ELEVATION	REPORT
------	-----------	--------

9-12

Comm 9-10-56
8" @ 299
Anh 811
Drlg 814

County Barton Elev. _____
 Sec. 27 Twp. 16 Rge. 12W
 Company Shields Oil Prod.
 Farm Name Penka No. 1

TOPS	DEPTH	LOG	DATUM
Anb.	811		
Tr.			
H.			
Tr.			
Dg.			
Bl.			
L.			
K.C.			
B.K.C.			
Ce.			
C.			
M.			
M.			
K.			
Mz.			
Me.			
V.			
S.			
S.			
A.			
R.			
Pe.			
G.			
T.D.			

Loc. in Sec. _____
SW SE NE
 Geol. _____
 Contr. _____
Duke Drlg.
TOOLS
 Pool _____
Kraft-Prusa

SEP 12 1956	

FIRST REPORT
 No. _____

Date Comm. 9/10/56
8" @ 299, Drlg. 814

Handwritten mark: JB

Stamp: SEP 11 1956

Stamp: SUNRAY

Co.
No.
T.
R.

County Barton Elev. 1921 DF
 Sec. 27 Twp. 16 Rge. 12W
 Company Shields Oil Prod.
 Farm Name Perka No. 1

TOPS	DEPTH	LOG	DATUM
Anh.	811		
Tr.			
H.	3002		
Tr.			
Dg.			
Bl.	3092		
L.			
K.C.	3108		
B.K.C.			
Ce.			
C.			
M.			
M.			
K.			
Mz.			
Ma.			
V.			
S.			
S.			
A.	3383		
R.			
Pe.			
G.			
T.D.	3400		

Loc. in Sec. SW SE NE
 Geol. _____
 Contr. _____
Duke Drlg.
TOOLS
Pool
Kraft-Prusa

	OCT 17 '56
	o
ABANDONED	

Date Comm. 9/10/56

311 299, Drlg. 074 SEP 19 '56 DST
~~3153~~ SEP 26 '56 3097-3153
15" rec 15' Md BHP 5/20"
DST 3352-3400 1hr rec 120
50CM BHP 900/20" 4 1/2 @
3400/ CN OCT 3 '56 ✓ OCT 10 '56 ✓
OCT 17 '56 DD 3403 LWL. PB 3400
14/3397-99 550 1/2 +std wtr PB
3393 24/3387-91 550 1/2 +std A//
wtr. D&Q