


DX 78-1 Barton

KANSAS

Section 27 Township 16 Range 12W

Well No. #1 Riemann

Company Jay Bergman Oil

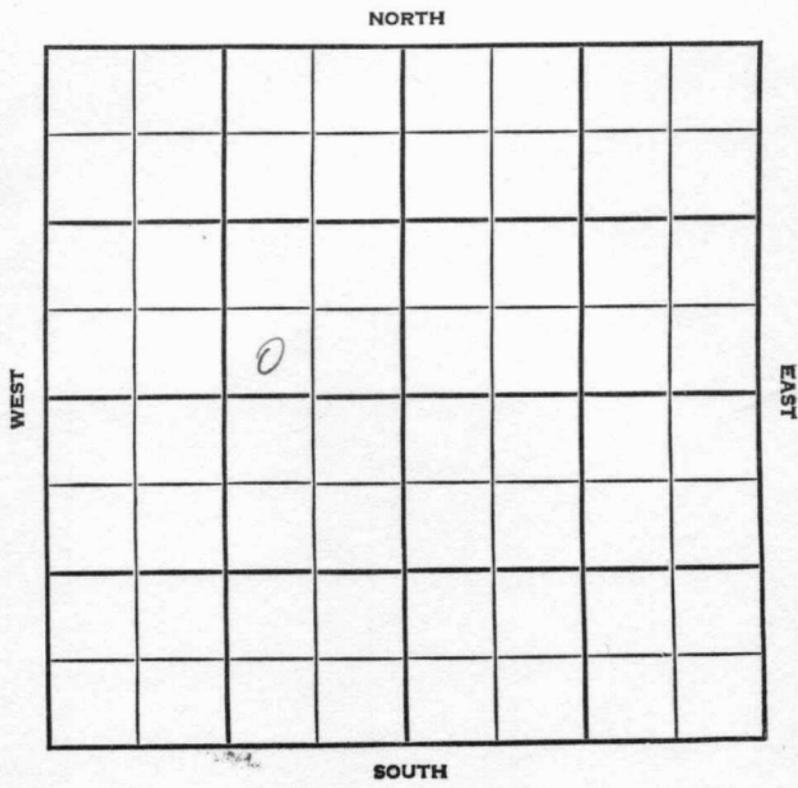

SEC.	TWP.	R.
27	16	12W


WELL NO. #1 Riemann FARM

COMPANY Jay Bergman Oil

CONTRACTOR Duke

Beaver

\_\_\_\_\_ FT. FROM N. LINE  
 \_\_\_\_\_ FT. FROM S. LINE  
 \_\_\_\_\_ FT. FROM E. LINE  
 \_\_\_\_\_ FT. FROM W. LINE

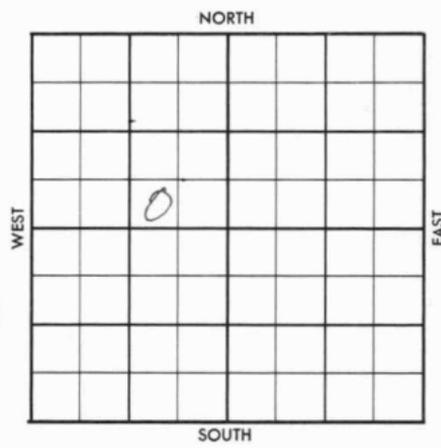

SW SE NW

1956	ELEVATION 1905'	REPORT
------	-----------------	--------

8-15 Comm. 8-9-56  
 8" @ 314 w/200  
 Drlg. 2250

8-22 ~~Comm.~~ DST 3251-68 op 1 hr., rec. 30' mud, BHP 570/20".  
 DST 3295-3305 op 1 hr., rec. 15' mud, BHP 640/20".  
 D & A  
 H. 2982'; BL. 3072'; L. 3089';  
 BKC. 3320'; C. 3352';  
 TD 3383'

**ABANDONED**

County Barton Elev. \_\_\_\_\_  
 Sec. 27 Twp. 16 Rge. 12W  
 Company Jay Bergman Oil  
 Farm Name Riemann No. 1

TOPS	DEPTH	LOG	DATUM	Loc. in Sec.
Anh.				SW SE NW
Tp.				
H.				
Tr.				
Dg.				
B.L.				
L.				Geol. _____
K.C.				Contr. _____
B.K.C.				
Ce.				<u>Duke</u>
C.				
M.				Pool _____
M.				<u>Beaver</u>
K.				
Mz.				
Me.				
V.				
S.				
S.				
A.				
R.				
Pe.				
G.				
T.D.				


FIRST REPORT

Date Comm. 8-9-56 AUG 15 '56  
8" @ 31 1/2 / 200 drlg. 2250

\_\_\_\_\_

\_\_\_\_\_

\_\_\_\_\_

\_\_\_\_\_

\_\_\_\_\_

\_\_\_\_\_

\_\_\_\_\_

*Handwritten mark resembling a stylized 'E' or '3' with a diagonal slash.*

Co.  
Lse.  
No.  
Sec.  
T.  
R.

County Barton Elev. 1905  
 Sec. 27 Twp. 16 Rge. 12W  
 Company Jay Bergman Oil  
 Farm Name Riemann No. 1

TOPS	DEPTH	LOG	DATUM	Loc. in Sec.
Anh.				SW SE NW
TP.				
H.	2982			
Tr.				
Dg.				
Bl.	3072			
L.	3089			Geol.
K.C.				Contr.
B.K.C.	3320			Duke
Ce.				
C.	3352			Pool
M.				Beaver
M.				
K.				
Mz.				
Mq.				
V.				
S.				
S.				
A.				
R.				
PE.				
G.				
T.D.	3383			

Date Comm. 8-9-56 AUG 22 1956

8" @ 314/200 drlg. 2250 AUG 22 56

DST 3257-68 gas thru sec 30' M

BHP 570/20 DST 3295-3305

thru sec 15' Md BHP 640/20"

DEA

Co.

Use.

No.

Sec.

T.

R.

