

FORM 51


Russell

KANSAS

Section 11 Township 15 Range 13W

Well No. #1 Rose (ROSS)

Company Lee Phillips

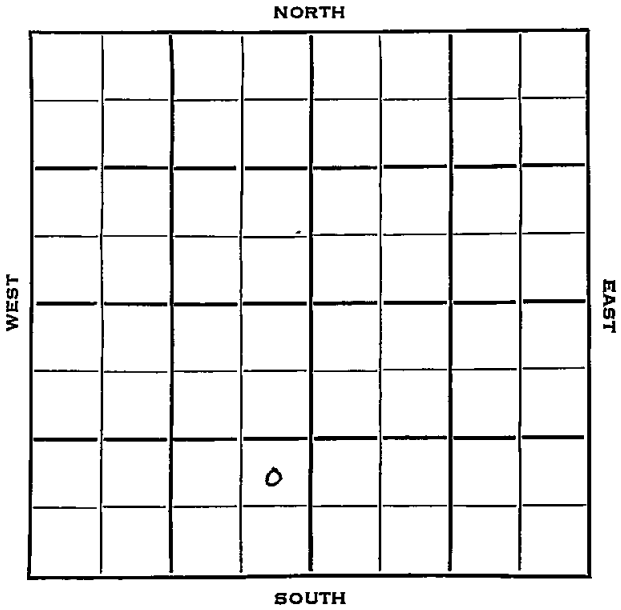

Russell

15

R.

13W

Sec. 11 Twp. _____

Well No. #4 Ross Farm _____

Lee Phillips Company _____

Brack Contractor _____


_____ Ft. from N. Line

990 Ft. from S. Line

330 Ft. from E. Line

_____ Ft. from W. Line

NE SE SW

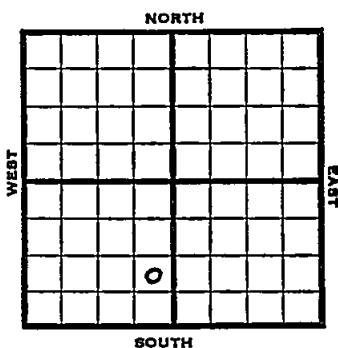

1953

Elev. 1822'

REPORT

3/25

Location

4/2

8" @ 495
Drlg. 2446'

4/9

Heeb 2912, Tar 2926, Br L. 2993, Lans 3009
RTD 3094 in Cong
5" @ 3106'

4/16

NR

4/23

Cong 3290'

4/30

24/3032-36, 2000A
PB 3025
26/3009-14, 2000A
F 45 BOPH, POP

5/6

Spud 3-24-53
Oil well TD 3294 8" @ 495' Heeb 2912
Tor 2926 Br lime 2993 Lans 3009
TD 3294 Cong 3290 5" @ 3106
24/3032-36 2000 A PB 3025
26/3009-14 2000 A F/45 BOPH
Comp. 50 BOPD

COMPLETED

