

Section 28 Township 16 Range 12W

Well No. 3 Finger

Company Derby Delg et al

Kraft-Prusa Pool

NORTH

WEST

EAST

SOUTH

KANSAS Barton ✓
R. 12W

Sec. 28 Twp. 16 R. 12W

Well No. 3 Finger Farm


Derby Drlg. et al Company
Kraft-Prusa Pool

Ft. from N. Line

330 Ft. from S. Line

Ft. from E. Line

990 Ft. from W. Line

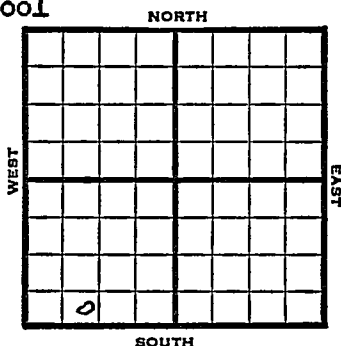

SE SW SW

1948 Elev. 1894' REPORT

11/17 RUR

11/23 "

11/30 8" @ 175

Drlg 2250'

12/8 Lansing 3098'

Arb 3344-49'

TD 3349'

5" @ 3345'

12/15 TD 3354'

Swb 2 bbls oil PH 6 hrs.

12/22 Arb 3344'

5" @ 3345'

500 acid

Pump 108 oil Pot.

Gr. 420

TD 3354'

COMPLETED

Map No. _____ Sec. 28 Twp. 16 R. 12W

Well No. 3 Finger

Derby Drlg. etal. Company

FIRST REPORT

_____ Contractor

SE SW SW

SECTION PLAT


_____ Ft. from N. Line

330 Ft. from S. Line

_____ Ft. from E. Line

990

_____ Ft. from W. Line

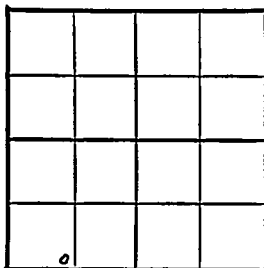

Barton County

Location _____

Rig up _____

Drilling and Remarks:

R U R

RECORD

Cased _____ in., _____ ft.

Sand _____

Gas _____

Oil _____

Total Depth _____

PRODUCTION

1st 24 hrs: Nat. _____

1st 24 hrs. after shot _____

Gas _____ Cu. Ft.

Dry Hole _____

Abandoned _____

Date

NOV 17 1948 19

S. J. LEWIS Scout

Kansas

Map No. 55 Sec. 28 Twp. 16 R. 12WWell No. 3 FingerDerby Drlg. etal.

Company

COMPLETE

Contractor

SE SW SW

E. 1884
SECTION PLAT Ft. from N. Line330 Ft. from S. Line Ft. from E. Line990 Ft. from W. Line

Barton County

Location Rig up

Drilling and Remarks:

R 833445" @ 33455000 cu ftRun 1050 ft42 000

RECORD

Cased in., ft.Sand Gas Oil Total Depth 3354

PRODUCTION

1st 24 hrs. Nat. 1st 24 hrs. after shot Gas Cu. Ft.Dry Hole Abandoned

Date

DEC 22 194819S. J. LEWIS

Scout