

Russell KANSAS

Section 11 Township 15 Range 13WWell No. #1 RossCompany Lee Phillips

NORTH

O.W.W.O.

WEST

EAST

SOUTH

Russell

KANSAS

Sec. 11 Twp. 15 R. 13W

Well No. #1 Ross Farm

Lee Phillips Company

Anschutz Drlg. - Contr. Contractor

Wildcat


Ft. from N. Line

330' Ft. from S. Line

330' Ft. from E. Line

Ft. from W. Line

SE SE SW

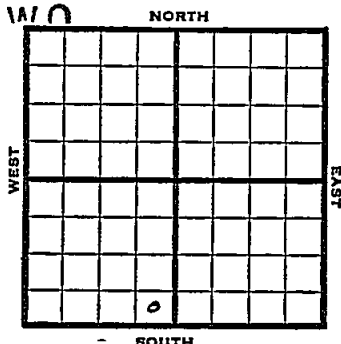

1950. Elev 1825' REPORT

11/22 Spud 11-18-50
8-5/8" @ 313'
Drlg. 555'
12/20 8 5/8" @ 313
Tarkio 2412 Heeb 2910
Toronto 2927 Douglas 2944
B. lime 2989 Lans 3003
SO 3005-09
DST 3025-33 opn 20 min rec 500' oil
DST 3068-75 opn 15 min rec 500' oil
Arb 3286-92
5" @ 3289
TD 3292
S/1 1/2 boph
500 A
S/65 bo 1st hr
50 bo 2nd hr
Comp 3000 bopd
Completed TD 3292'
COMPLETED

OVER

1951

O.W.W.O.

11/7 Lans. 3000'
Arb. 3283

OTD 3291 was Arb prod.

PB 3203 16/3024-31

3000 A S/20 boph

P 608 bopd Comp.

**FIRST REPORT
COMPLETED**

J. E. TYRA

County Russell State Kansas

Sec. **11** (Blk. Twp.) **15** (Sur. Rge.) **13W** Map No.

Operator Lee Phillips

Well No. 1 Farm Ross

Elev.	Location	SE	SE	SW
-------	----------	----	----	----

**FIRST REPORT
COMPLETE**

330 Ft. From S Line SW

330 Ft. From E Line Quarter

Ist. Report **NOV 7 1951**

Completion NOV 7 1951

Remarks (OVTWO)

Spudding Date _____

Drlg. Data

Lans 3000 Arb 3283 OTD 3291 was arb prod.

PB 3203 16/3024-31. 3000A S/20 Boph

P 608 Bopd. Comp.

J. E. TYRA