BARTON KANSAS

28 16S 12W

SECTION TOWNSHIP RANGE

WELL NO. #1 Finger

COMPANY D. R. Lauck Oil Co.

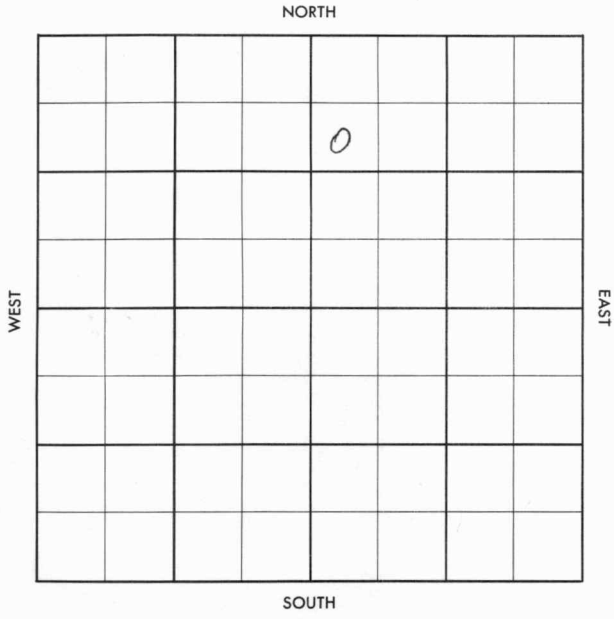

FORM 504-3 SUNRAY

Barton KANSAS

SEC.	TWP.	R.
~~28~~ 33	16S	12W

WELL NO.

1 Finger FARM

COMPANY

D. R. Lauck Oil Co.

CONTRACTOR

Co. rig #2

Laudic

_____ FT. FROM N. LINE

_____ FT. FROM S. LINE

_____ FT. FROM E. LINE

_____ FT. FROM W. LINE

SW NW NE ~~SE~~ - ~~NE¼~~

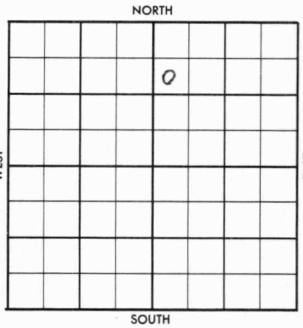

1956	ELEVATION 1885' REPORT
6-20	Comm. 6-17-56 8" @302 w/175
7-11	DST 3078-3110 op 30 min, rec. 15' mud, 575/20" DST 3336-49 op 30 min, rec. 10' mud, BHP 0#. DST 3352-60 op 30 min, rec. 30' mud, 840/20". DST 3357-65 op 1 hr, 40' SOCM & 30' VSOCM, ~~#####~~ 820/30". 5½" @ 3353 CO 3365 Tst ld, no fluid D & A H. 2984'; Tr. 3001'; Dg. 3012'; BL. 3075'; L. 3090'; C. 3338';A. 3351'; TD 3365'

ABANDONED

FORM 504-5 SUNRAY

FORM 513 SUNRAY

County Barton Elev.

Sec. 28 Twp. 16S Rge. 12W

Company D. R. Lauck Oil Co.

Farm Name Finger No. 1

TOPS	DEPTH	LOG	DATUM
Anh.			
T.p.			
H.			
Tr.			
Dg.			
B.L.			
L.			
K.C.			
B.K.C.			
Ce.			
C.			
M.			
M.			
K.			
Mz.			
Mo.			
V.			
S.			
S.			
A			
R.			
P€.			
G.			
T.D.			

Loc. in Sec. SW NW NE

DS - NE¼

Geol.

Contr. Co. rig #2

Pool Laudic



JUN 20 '56

Date Comm. 6-17-56

8" 302 w/175

Co. Lse. No. Sec. T. R.

CORRECTION

FORM 513 SUNRAY

County Barton Elev. 1885

Sec. ~~28~~ 33 Twp. 16S Rge. 12W

Company D. R. Lauck Oil Co.

Farm Name Finger No. 1

TOPS	DEPTH	LOG	DATUM
Anh.			
Tp.			
H.	2984		
Tr.	3001		
Dg.	3012		
Bl.	3075		
L.	3090		
K.C.			
B.K.C.			
Ce.			
C.	3338		
M.			
M.			
K.			
Mz.			
Mo.			
V.			
S.			
S.			
A	3351		
R.			
PE.			
G.			
T.D.	3365		

Loc. in Sec. SW NW NE

DS - NE¼

Geol.

Contr. Co. rig #2

Pool Laudic



JUL 11 1956

Date Comm. 6-17-56

8" 302 w/175 JUN 27 '56 DST 3078-3110 30" rec 15' Md 525/20 ℗ 3280 JUL 3 '56 DST 3336-49 30" rec 10' Md BHP 0 DST 3352-60 30" rec 30' Md 840/20 DST 3357-65 1hr 40' SOCM + 30' VSOCM 820/30" 5½ @ 3353 JUL 11 '56 CO 3365 550 Ft Lst Ld 1/2 no Fluid Nitro no Fluid D&A

Co. Lse. No. Sec. T. R.