


Section 28 Township 16 Range 12 ~~W~~

Well No. #2 Finger

Company Derby Drlg.

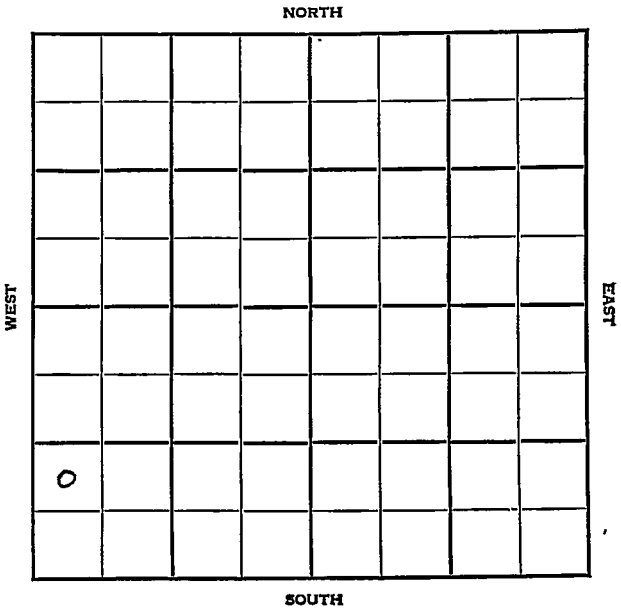

KANSAS

Barton



Sec. 28 Twp. 16 R. 12W

Well No. #2 Finger Farm

Derby Drlg. Company

Laudick Pool


_____ Ft. from N. Line

990' Ft. from S. Line

_____ Ft. from E. Line

330' Ft. from W. Line

NW SW SW

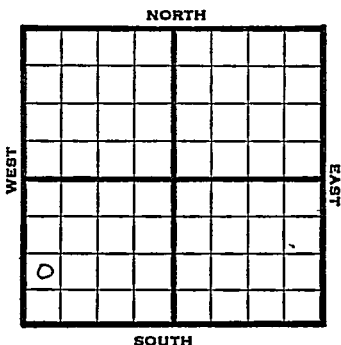

1948 Elev. 1896' REPORT

5/5 8" @ 184'
WOC

5/12 Drlg. 2310'

5/19 Topeka 2756'
Lansing 3100'
Arbuckle 3352'
TD 3356'
5" @ 3353'
RUST

5/26 2600' oil 12 hrs.

6/1 "

6/9 Arb. 3352'
5" @ 3353'
Pump 75 oil pot
Gr. 40.0
TD 3356'
Comp.

COMPLETED

Map No. _____ Sec. 28 Twp. 16 R. 12W

Well No. 2 Finger

Derby Drlg. Company

FIRST REPORT

Contractor

NW SW SW

SECTION PLAT

_____ Ft. from N. Line

990 Ft. from S. Line

_____ Ft. from E. Line

330 Ft. from W. Line

o			

Barton County.

Location _____

Rig up _____

Drilling and Remarks:

8" @ 184 WOC

RECORD

Cased _____ in., _____ ft.

Sand _____

Gas _____

Oil _____

Total Depth _____

PRODUCTION

1st 24 hrs. Nat. _____

1st 24 hrs. after shot _____

Gas _____ Cu. Ft.

Dry Hole _____

Abandoned _____

Date

MAY 5 1948 19 S. J. LEWIS Scout

Map No. 55 Sec. 28 Twp. 16 R. 12W

Well No. 2 Finger

Derby Drlg. Company

COMPLETE

Contractor

NW SW SW

E. 1896

SECTION PLAT

 Ft. from N. Line

990. Ft. from S. Line

 Ft. from E. Line

330 Ft. from W. Line

6			

Barton County

Location

Rig up

Drilling and Remarks:

Per 83352

5" 83353

Run 75 oil Pad

40° SW

RECORD

Cased in., ft.

Sand

Gas

Oil ✓

Total Depth 2356

PRODUCTION

1st 24 hrs. Nat.

1st 24 hrs. after shot

Gas Cu. Ft.

Dry Hole

Abandoned

Date

JUN 9 1948 19

S. J. LEWIS

Scout