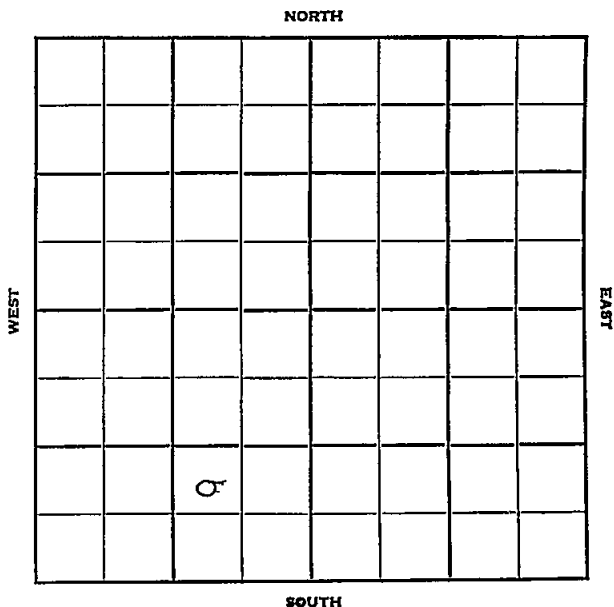


Section 11 Township 15 Range 13WWell No. #2 RossCompany L. E. Phillips

Russell

KANSAS

Sec. 11 Twp. 15 R. 13W

Well No. #2 Ross Farm

L. E. Phillips Company

Isern - Contr. Contractor

Trapp


Ft. from N. Line

996' Ft. from S. Line

990' Ft. from E. Line

Ft. from W. Line

NW SE SW

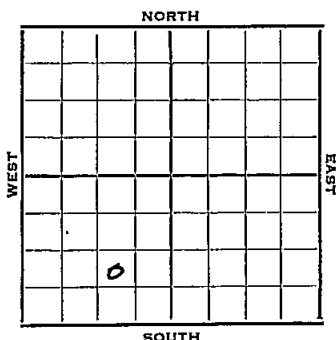

1951 Elev. 1841' REPORT

12/19 RUR

1952

1/30

Spud 12-18-51

Oil Well TD 3305

8" @ 350

Tarkio 2461 DST 2461-75 open 1 hr.

Rec. 5' free oil 55' wtr. 5' mud

Heeb. 2929 Br. Li 3007 Lans. 3024

DST 3044-54 open 20 min. rec. 270'


mco Arb. 3300 TD 3305 5" @ 3302

36/ 3043-51 4000 A Comp. 575

BOPD 2% wtr.

COMPLETED

County Russell State Kansas
Sec. 11 (Blk.) 15 (Sur.) 13W Map No.
Operator L. E. Phillips
Well No. 2 Farm Ross
Elev. _____ Location NW SE SW

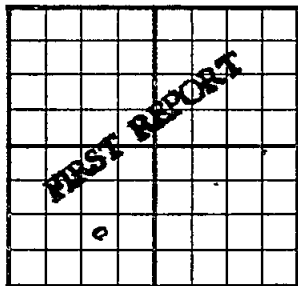

990 Ft. From S Line SW

990 Ft. From E Line Quarter

1st. Report DEC 1 8 1951

Completion _____

Remarks _____

Isern - Contr.

Spudding Date _____

Drlg. Data Trapp

RUR

J. E. TYRA



COMPLETE

COMPLETE

Drlg. Data	Oil well	TD 3305
8" @ 350	Tarkio 2461	DST 2461-75
open 1 hr.	Rec. 5' free oil	55' water
5' mud	Heeb. 2929	Br. lime 3007
Lans. 3024	DST 3044-54	open 20 min.
Rec. 270' mco	Arb. 3300	TD 3305
5" @ 3302	36/ 3043-51	4000 A
Comp. 575 bopd	2% water	

J. G. McGEHEE