

Section 11 Township 15 Range 13 W

Well No. # 1 Parker

Company Isern Drilling Co.

NORTH

		0					

WEST

EAST

SOUTH

Sec. 11 Twp. 15 R. 13W

Well No. #1 Parker Farm

Isern Drilling Co. Company

Ely Contractor


990 Ft. from N. Line

_____ Ft. from S. Line

990 Ft. from E. Line

_____ Ft. from W. Line

SW NE SW

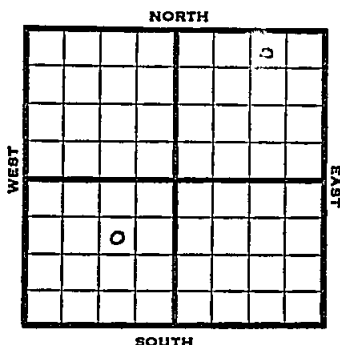

1951

Elev. 1842'

REPORT

11/7

RUR

1952

1/9

Spud 11-6-51

Oil well TD 3325' 8" @ 165'

Anhy 795' 1st Tarkio 2375'

2nd Tarkio 2472'

DST 2439-84 open 1 hr. rec 90' oil & GCM & free oil

Heeb 2941' Tor. 2958' Base Oread

2974' Br. lime 3020' Lans. 3033'

DST 3052-68 open 15 min. rec 60' oil 150' OCM

Arb. 3315-25' 5" @ 3322' CO to 3293'

71/3049-62 S/1 1/2 BOPH 12 hr.

1000 A S/20 BOPH

Comp. 392 BOPD

COMPLETED

County Russell State Kansas

Sec. 11 (Blk. Twp.) 15 (Sur. Rge.) 13W Map No.

Operator Isern Drilling Co.

Well No. 1 Farm Parker

Elev. _____ Location SW NE SW

FIRST REPORT											

990 Ft. From N Line SW

990 Ft. From E Line Quarter

Ist. Report NOV 7 1951

Completion _____

Remarks _____

Spudding Date _____

Drlg. Data Ely

RUR

J. E. TYRA

