


Section 28 Township 16 Range 12 W

Well No. #1 Hitchman

Company C&C Pet. and Harms & Burt

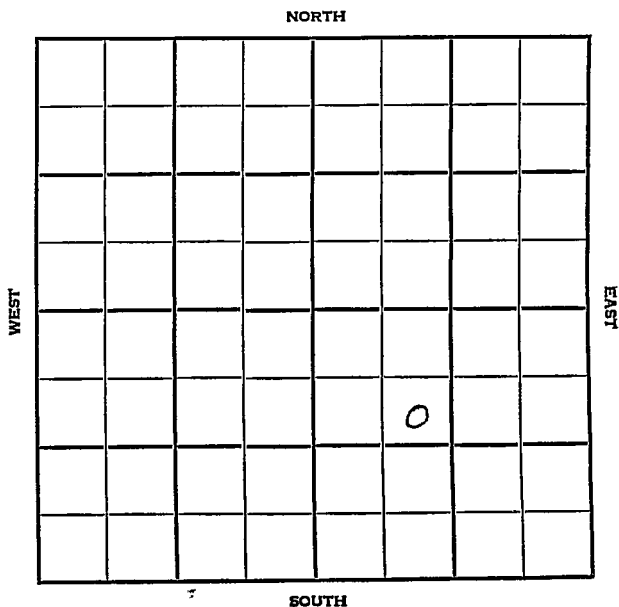

Barton

KANSAS

SEC.	TWP.	R.
28	16	12W

WELL NO. #1 Hitchman FARM

COMPANY C & C Pet & ~~Harms~~ Harms & Burt

CONTRACTOR Harms-Burt


S. Beaver

_____ Ft. from N. Line

_____ Ft. from S. Line

_____ Ft. from E. Line

_____ Ft. from W. Line

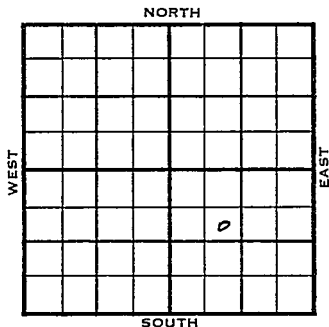

SE NW SE

1955	ELEVATION 1903'	REPORT
------	--------------------	--------

8/24

Location

9-7

8 5/8" @ 210 w/200
DST 3277-3315 30", rec. 3' mud FP 0
BHP 90# 20" no log

D & A

<u>TOPS</u>	<u>DEPTH</u>
Anh.-	810
H.	3010
B.L.	3098
L.	3114
B.K.C.	3359
A	3385

T.D. 3400'

ABANDONED

County Barton Elev. _____
 Sec. 28 Twp. 76 Rge. 12W
 Company C & C Pet. and Harms & Burt
 Farm Name Hitchman No. 1

TOPS	DEPTH	LOG	DATUM
Anh.			
Tp.			
H.			
Tr.			
Dg.			
Bl.			
L.			
K.C.			
B.K.C.			
Ce.			
C.			
M.			
M.			
K.			
Mz.			
Me.			
V.			
S.			
S.			
A			
R.			
Pe.			
G.			
T.D.			

Loc. in Sec. SE NW SE

Geol. _____
 Contr. Harms-Burt

Pool S. Beaver

AUG 24 '55
FIRST REPORT

Date Comm. _____

Location _____

Co.
 Lse.
 No.
 Sec.
 T.
 R.

County Barton Elev. 1903Sec. 28 Twp. 6 Rge. 12WCompany C & C Pet. and Harms & BurtFarm Name Hitchman No. 1

TOPS	DEPTH	LOG	DATUM	Loc. in Sec.
Anh.	<u>810</u>			<u>SE NW SE</u>
Tp.				
H.	<u>3010</u>		<u>1107</u>	
Tr.				
Dg.				
Bl.	<u>3098</u>		<u>1195</u>	
L.	<u>3114</u>		<u>1211</u>	Geol. <u>Allen</u>
K.C.				Contr.
B.K.C.	<u>3359</u>		<u>1456</u>	<u>Harms-Burt</u>
Ce.				Pool
C.				<u>S. Beaver</u>
M.				
M.				
K.				
Mz.				
Mq.				
V.				
S.				
S.				
A	<u>3385</u>		<u>1482</u>	ABANDONED
R.				
Pe.				
G.				
T.D.	<u>3400</u>			

Date Comm. 8/25/55 **SEP** 7 19558 5/8" 210 w/200 DST 3277-3315 30" Rec.3' mud FP 0 BHP 90# 20" no logD & A