

32.36

Margret Peacock. No. 2.  
N 1/2 SE of Section 36, Township 32, Range 4 East,  
Cowley County, Kansas.

Elevation 1200'.

Soil		11	11
Lime		4	15
Clay	yellow	5	20
Lime		100	120
Lime		10	130
Rock	red	15	145
Shale	blue	15	160
Lime	soft	20	180
Rock	red	6	186
Lime		14	200
Rock	red	30	230
Lime		10	240
Shale		20	260
Lime		35	295
Shale		5	300
Lime		10	310
Lime	broken	10	320
Lime		5	325
Shale		5	330
Lime		15	345
Shale		5	350
Rock	red	20	370
Shale	blue	20	390
Rock	red	20	410
Sand	dark	10	420
Shale		8	428
Lime		6	434
Lime		18	452
Shale		10	462
Lime		15	477
Shale		5	482
Lime		40	522
Shale	blue	6	528
Lime		7	535
Slate		20	555
Lime		7	562
Shale	blue	14	576
Lime		14	590
Shale		35	625
Lime		10	635
Shale		10	645
Lime	broken	15	660
Sand	gas	10	670
Shale	dark	7	677
Lime	white	6	683
Shale	blue	20	703
Lime	white	8	711
Shale	light	24	735
Lime	white	5	740
Shale	blue	85	825
Lime		6	831
Shale		35	866
Shale		5	875
Lime		6	882
Shale		5	887
Lime		5	892
Lime		20	912
Shale	blue	5	917
Lime		20	937
Shale	blue	18	955
Lime	light	10	965
Shale	blue	40	1005
Lime	gray	12	1017
Shale	blue	13	1030
Lime		3	1033
Shale	dark	5	1038
Lime	light	15	1053
Shale	dark	35	1088

11-25-1916 (Completion Card)  
12-30-1916 (KAS-DRL)

U

Page 2.

M. Peacock. No. 2.

Lime		5	1093
Shale		10	1103
Sand	water	20	1123-cave
Shale		10	1133
Lime		10	1143
Shale		30	1173
Shale		22	1195
Lime		5	1200
Shale		23	1223
Lime	light	20	1261
Shale	light	5	1266
Lime	light	11	1277
Shale	light	11	1288
Shale	light	10	1298
Lime shell		9	1307
Lime		20	1327
Shale	dark	3	1330
Lime	light	7	1337
Shale	dark	5	1342
Lime	dark	25	1367
Lime	light	27	1394
Shale	blue	8	1402
Lime	light	5	1407
Shale	light	14	1423
Sand	light	20	1443


First five hours flowed 40 barrels in tank.

Cowley, Kas.

Sec. 36 Twp. 32. Rec. 7  
Farm Mary Peacock, No. 2  
Empire Gas & Fuel Company  
Elev. 1200 Ft. T. D.  
Log No. 17

20811

Soil - 0 - 11	sh - 917
Li - 15	Li - 937
Clay - 20	sh - 955
Li - 130	Li - 965
R.P. - 145	sh - 1005
sh - 160	Li - 1007
Li - 180	sh - 1030
R.P. - 186	Li - 1033
Li - 200	sh - 1038
R.P. - 230	Li - 1053
Li - 240	sh - 1088
sh - 260	Li - 1093
Li - 295	sh - 1103
sh - 300	sd - 1123
Li - 320	sh - 1133
Li - 325	Li - 1143
sh - 330	sh - 1195
Li - 350	Li - 1200
R.P. - 370	sh - 1223
Li - 390	Li - 1261
R.P. - 410	sh - 1266
sd - 420	Li - 1277
sh - 428	sh - 1288
Li - 452	sh - 1298
sh - 462	Li - 1327
Li - 477	sh - 1330
sh - 482	Li - 1337
Li - 522	sh - 1342
sh - 528	Li - 1367
Li - 535	sh - 1423
sh - 555	sd - 1443
Li - 562	
sh - 576	
Li - 590	
sh - 625	
Li - 635	
sh - 645	
Li - 660	
sd - 670	
sh - 677	
Li - 683	
sh - 703	
Li - 711	
sh - 735	
Li - 740	
sh - 825	
Li - 831	
sh - 866	
sh - 876	
Li - 882	
sh - 887	
Li - 912	

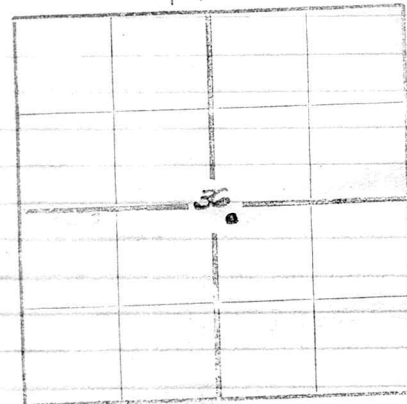

Days cannot  
locate the well  
in field