

# KANSAS

Russell


FORM 51 5M 10-41 PETROL

Section 11 Township 15 Range 13-W

Well No. #1 Lipprand

Company Phil Han & Nate Appleman

NORTH Wildcat

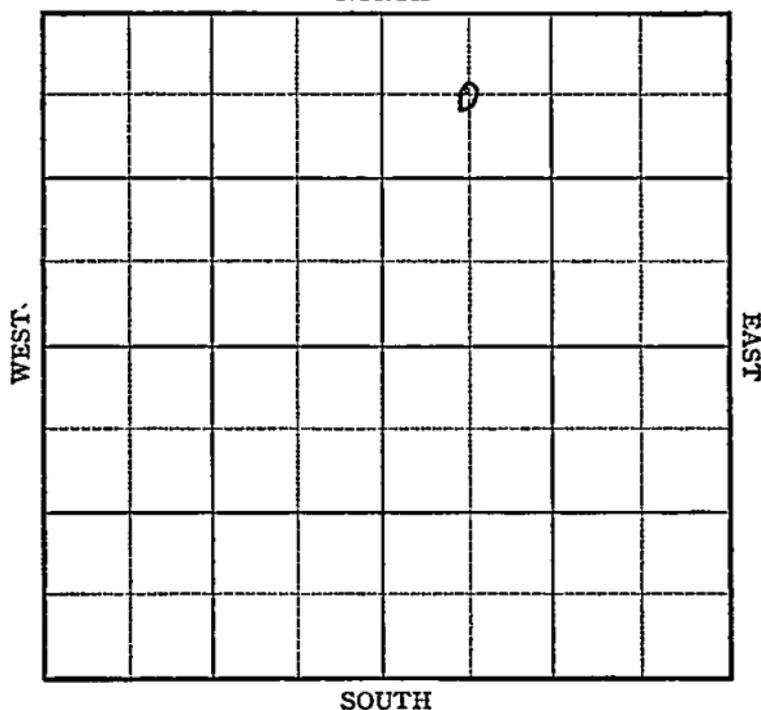

Sec. 11 Twp. 15 R. 13-W

Well No. #1 Lipprand Farm

Phil Han & Nate Appleman Company

(Wildcat)


660 Ft. from N. Line

         Ft. from S. Line

         Ft. from E. Line

660 Ft. from W. Line

Elev. 1827

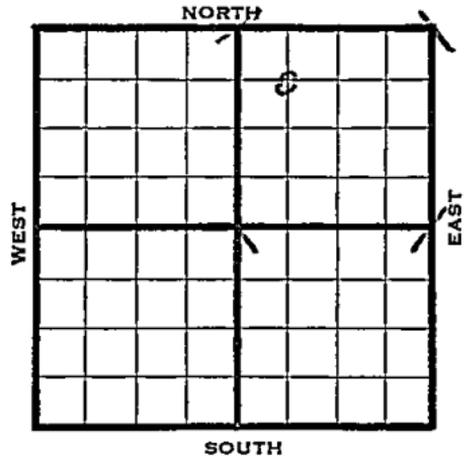

1942	REPORT
7/1	Location
7/8	Spd. Waiting on rig.
7/15	"
7/22	Cable rig.
7/29	15" - 260 Drlg. 375'
8/5	Anhy 775                      10" - 785
	Drlg. 1645'
8/12	8" @ 2447                      Drlg 2470
8/19	Topeka 2673
	Drlg. 3065'
8/27	Lans. 3027
	Arb. 3354
	7" - 3266
	HFW
	T.D. 3375' <b>ABANDONED</b>

Russell KANSAS


Map No. 73 Sec. 11 Twp. 15 R. 13WWell No. 1 LippbrandPhil Han & Nate Applemar Company**FIRST REPORT**

Contractor

Approx.

C NW NE

## SECTION PLAT

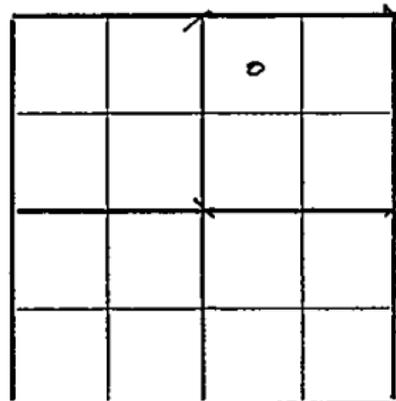660 Ft. from N. Line

\_\_\_\_\_ Ft. from S. Line

\_\_\_\_\_ Ft. from E. Line

660 Ft. from W. Line

Wildcat

Location XXX

Rig up \_\_\_\_\_

Drilling and Remarks:

## RECORD

Cased \_\_\_\_\_ in., \_\_\_\_\_ ft.

Sand \_\_\_\_\_

Gas \_\_\_\_\_

Oil \_\_\_\_\_

Total Depth \_\_\_\_\_

## PRODUCTION

1st 24 hrs. Nat. \_\_\_\_\_

1st 24 hrs. after shot \_\_\_\_\_

Gas \_\_\_\_\_ Cu. Ft.

Dry Hole \_\_\_\_\_

Abandoned \_\_\_\_\_

Date

JUL 1 1942 19S. J. LEWIS

Scout

Russell KANSAS

Map No. 73 Sec. 11 Twp. 15 R. 13WWell No. 1 Lipprand- Phil-Han & N. Appleman Company**ABANDONED**

Contractor

C NW NE Approx.

## SECTION PLAT

660 Ft. from N. Line

\_\_\_\_\_ Ft. from S. Line

\_\_\_\_\_ Ft. from E. Line

660 Ft. from W. Line

		o	

WILDCAT

Location \_\_\_\_\_

Rig up \_\_\_\_\_

Drilling and Remarks:

*Lane 3027*  
*CR 8354*  
*7" @ 8266*  
*X P.V.*

## RECORD

Cased \_\_\_\_\_ in., \_\_\_\_\_ ft.

Sand \_\_\_\_\_

Gas \_\_\_\_\_

Oil \_\_\_\_\_

Total Depth 3325

## PRODUCTION

1st 24 hrs. Nat. \_\_\_\_\_

1st 24 hrs. after shot \_\_\_\_\_

Gas \_\_\_\_\_ Cu. Ft.

Dry Hole \_\_\_\_\_

Abandoned \_\_\_\_\_

Date

AUG 27 1942 19S. J. LEWIS Scout