


Section 28 Township 16 Range 12W

Well No. #1 Hitschman

Company J.C. Dozier

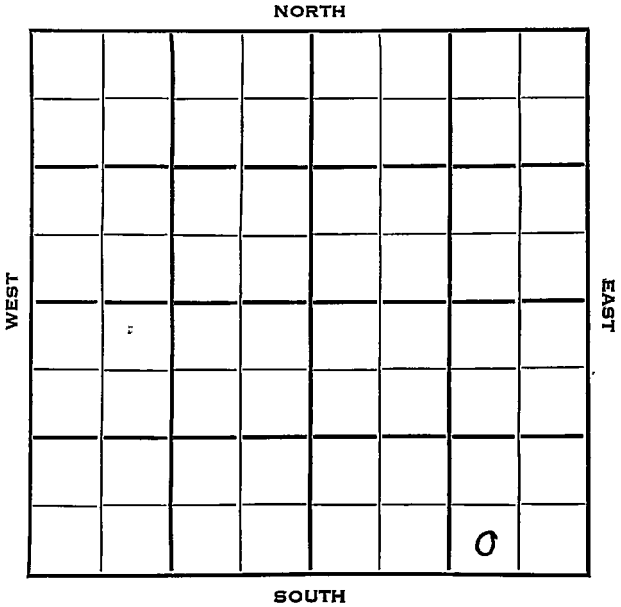

Barton

KANSAS ✓

Sec. 28 Twp. 16 R. 12W

Well No. #1 Hitschman Farm

J.C. Dozier Company

Buick Drlg. Contractor

Laudick Pool


 Ft. from N. Line

330 Ft. from S. Line

990 Ft. from E. Line

 Ft. from W. Line

SW SE SE

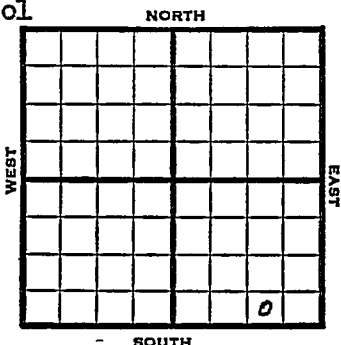

1953

REPORT

Elev. 1887'

4/29

R U R

5/7

8" @ 196'

Drlg. 890'

5/21

KC 3088 Arb. 3346 RTD 3360

5" @ 3352

5/28

N.R.

6/3

Spud 5-2-53

D & A TD 3370 8" @ 196

Heeb 2982' Br line 3070' KC 3088

Arb. 3346 TD 3360 5" @ 3352

CO to 3360 DD 3370 500 A

3 BWPH 1/3 BOPH

D & A

ABANDONED

County **Barton** State **Kansas**

Sec. 28 (Blk.) 16 (Sur.) 12W Map No.

Operator **J. C. Dozier**

Well No. **1** Farm **Hitschman**

Elev.	Location	SW	SE	SE
-------	----------	----	----	----

FIRST REPORT

330 Ft. From S Line SE

990 Ft. From E Line Quarter

1st. Report APR 20 1953

Completion

Remarks


Buick Drlg. - Contr.

Spudding Date _____

Drlg. Data Laudick Pool

R U R

County Barton State Kansas
 Sec. 28 (Blk. 16) (Sur. 12W) (Twp. Map No.)
 Operator J. C. Dozier
 Well No. 1 Farm Hitschman
 Elev. 1887 Location SW SE SE

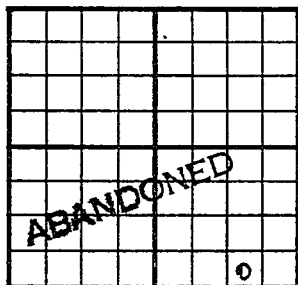

330 Ft. From S Line SE
990 Ft. From E Line Quarter

1st. Report

Completion JUN 3 1953

Remarks Laudick Pool

Buick Drlg. - Contr.

Spudding Date 5-2-53

Drlg. Data D & A TD 3370

8" @ 196 Heeb. 2982 Br. lime 3070

KC 3088 Arb. 3346 TD 3360 5" @ 3352

CO to 3360 DD 3370 500 A 3 bwph

1/3 boph

D & A

J. G. McGEHEE