


KANSAS

FORM 51 25M 3-49 PETROL

Section 11 Township 15 Range 13-W

Well No. #1 Ross

Company D. R. Laucke

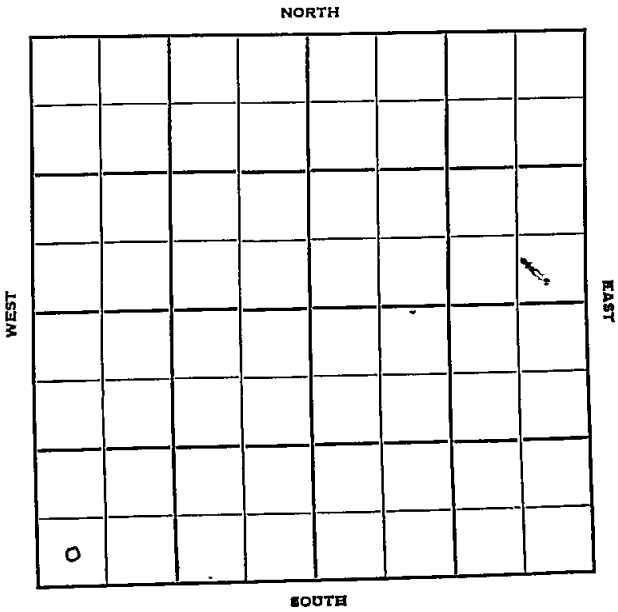

Sec. 11 Twp. 15 **KANSAS** R. 13-W

Well No. #1 Ross Farm

D R Laucke Company

Stenns Drlg Contractor


 Ft. from N. Line

336 Ft. from S. Line

 Ft. from E. Line

330 Ft. from W. Line

SW SW SW

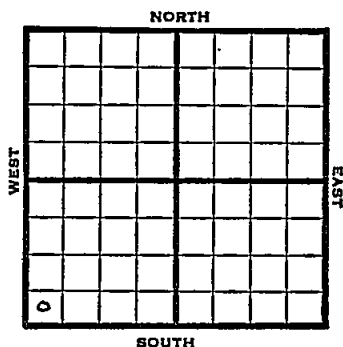

1950

Elev 1834

REPORT

5/17

Rig Up

7/5

15" @ 305

Anhy 783-823

10" @ 784

Hole caving @ 2347

TD 2500

D&A

ABANDONED

Kansas

Map No. _____ Sec. 11 Twp. 15 R. 13W

Well No. 1 Ross

D. R. Leuchte _____ Company

Stenns Drlg. _____ Contractor

S¹ S² S³

SECTION PLAT

_____ Ft. from N. Line

330 Ft. from S. Line

_____ Ft. from E. Line

330 Ft. from W. Line



Russell

Location _____

Rig up _____

Drilling and Remarks:

RECORD

Cased _____ in., _____ ft.

Sand _____

Gas _____

Oil _____

Total Depth _____

PRODUCTION

1st 24 hrs. Nat. _____

1st 24 hrs. after shot _____

Gas _____ Cu. Ft.

Dry Hole _____

Abandoned _____

Date

MAY 17 1950

19

J. E. TYRA Scout


Kansas

Map No. _____ Sec. 11 Twp. 15 R. 13WWell No. 1 Ross

_____ D. R. Lauck _____ Company

_____ Contractor

SW SW SW

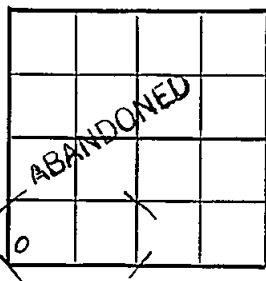El. 1834
SECTION PLAT~~784~~ Ft. from N. Line330 Ft. from S. Line~~330~~ Ft. from E. Line330 Ft. from W. Line

Russell County

Location _____

Rig up _____

Drilling and Remarks:

15" 305

Anhy 783-823

10" 784

Hole caving C 23 17

TD 2500

D & A

RECORD

Cased _____ in., _____ ft.

Sand _____

Gas _____

Oil _____

Total Depth 2500

PRODUCTION

1st 24 hrs. Nat. _____

1st 24 hrs. after shot _____

Gas _____ Cu. Ft.

Dry Hole _____

Abandoned _____

Date

JUL 5 1950 19J. E. TYRA Scout