


Section 11 Township 15 Range 13W

Well No. #3 Parker

Company Isern Drlg.

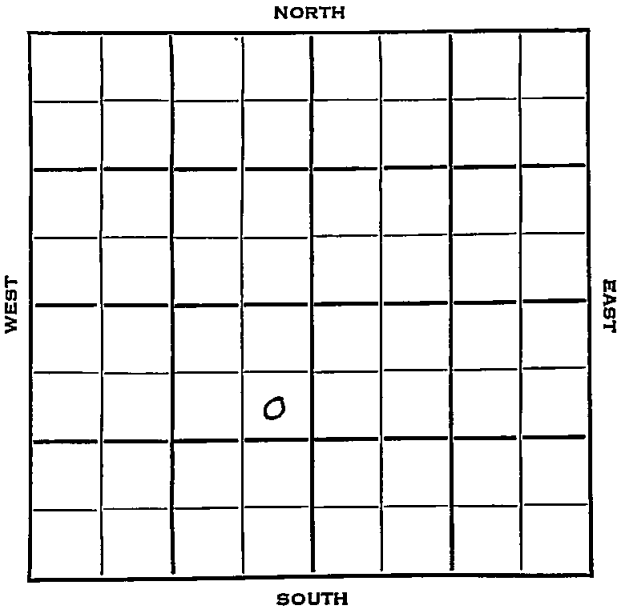

Sec. 11 Twp. 15 R. 13W

Well No. #3 Parker Farm

Isern Drlg. Company

Isern Contractor

Trapp Pool


990 Ft. from N. Line

329 Ft. from S. Line

330 Ft. from E. Line

\_\_\_\_\_ Ft. from W. Line

SE NE SW

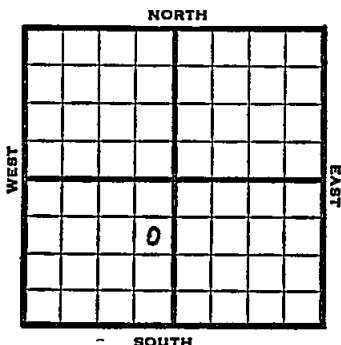

1953 Elev. 1834' REPORT

4/29 M I R

5/7 8" @ 165'

Tarkio - ?

DST 2448-85 opn 1 hr, 240' SO&GCM, 220#  
Drlg. 2685'

5/21 NR

5/28 "

6/3 "

6/24 NR

7/1 "

7/22 NR

8/26 Spud 4-29-53 Oil well TD 3310

8" @ 165' Tarkio 2434

DST 2448-85 open 1 hr rec 240' SO &

GCM 220# Tarkio 2470 Heeb 2938

Tor 2956 Br lime 3017' Lans 3031

DST 3033-41 open 1 hr rec 30' mud&

VSSO

DST 3051-65 open 3/4 hr rec 15' mud &

VSSO 190#

DST 3191-3240 open 40 min rec 50' mud

245# TD 3310' 5" @ 3106 CO to 3064

36/2959-65 dry 500 A S/15 GO 31 GW

2 hr. SP 2625 3/2524 - 3/2438 Sq

2959-65 PB 2476 1 BO 4 BWPH

Perf 2466-72 1500 A S-dfrac.

Comp. 15 BOPD 15 BW **COMPLETED**



