


Section 11 Township 15 Range 13W

Well No. #1 Kejr "C"

Company Shell

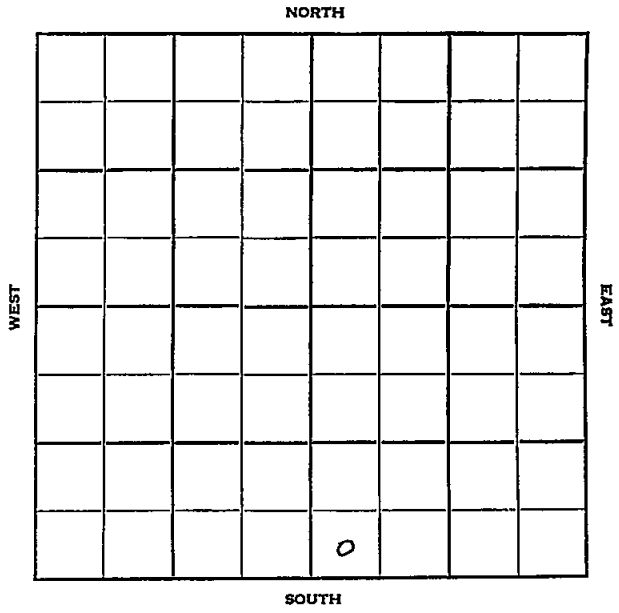

Russell

KANSAS

Sec. 11 Twp. 15 R. 13 W ✓

Well No. # 1 Kejr "C" Farm

Shell Company

B & R Drlg. Contractor


\_\_\_\_\_ Ft. from N. Line

330 Ft. from S. Line

\_\_\_\_\_ Ft. from E. Line

330 Ft. from W. Line

SW SW SE

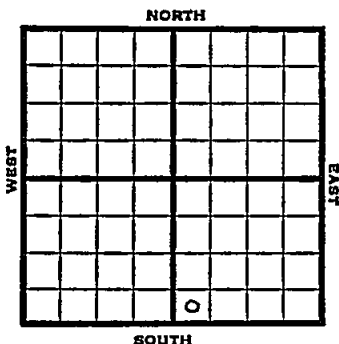

1951

Elev. 1806' REPORT

4/4

Location

8/22

Spud 4-7-51  
 Oil well TD 3293' 8" @ 769'  
 Tarkio 2390' Top 2662' Heeb 2889'  
 Tor. 2909'  
 DST 2885-2923' open 45 min. rec 180'  
 HO & GCM, 180' HGC oil.  
 Br line 2973' Lans. 2988'  
 DST 3159-80' open 1/2 hr. rec 30' OCM  
 Arb. 3291' TD 3293' 4 1/2" @ 3292'  
 DC 3275 46/3168-80 3000 A  
 SP 3163' 36/3148-57 B/7 GO 32 GWPH  
 1000 A S/10 BF 3 hr. 25% water  
 SP 3115' 72/3252-70 B/11 GW SSO ph  
 1000 A S/1 BO 7 BWPH 6 hr.  
 SP 3100' 1000 A S/1 BO 7 BWPH  
 SP 3045' 80/3010-30 Test SO & wtr.  
 SP 3032' 1000 A S/3/4 BO 1 hr.  
 F/165 BO 8 1/2 hr.  
 F/120 BO 5 hr. 1% water  
 Comp. 238 BOPD

COMPLETED



County Russell State KansasSec. 11 (<sup>Blk.</sup>Twp.) 15 (<sup>Sur.</sup>Rge.) 13W Map No.Operator ShellWell No. 1 Farm Kejr "C"Elev. 1806 Location SW SW SE


330 Ft. From S Line SE330 Ft. From W Line Quarter1st. ReportCompletion AUG 22 1951RemarksB & R Drlg. - Contr.Spudding Date 4-7-51Drlg. Data Oil well TD 32938" @ 769 Tarkio 2390 Top. 2662Heeb. 2889 Tor. 2909 DST 2885-2923open 45 min. Rec. 180' ho & gcm 180'hgcoil Br. lime 2973 Lans. 2988DST 3159-80 open  $\frac{1}{2}$  hr. Rec. 30' ocmArb. 3291 TD 3293  $4\frac{1}{2}$ " @ 3292DC 3275 46/ 3168-80 3000 A SP 316336/ 3148-57 B/ 7 go 32 gwph 1000 AS/ 10 bf 3 hr. 25% water SP 311572/ 3252-70 B/ 11 gw SSO ph 1000 AS/ 1-bo 7 bwph 6 hr. SP 3100 1000 AS/ 1 bo 7 bwph . SP 3045 80/ 3010-30test SO & water SP 3032 1000 AS/ 34 bo 1 hr. F/ 165 bo  $8\frac{1}{2}$  hr.

J. E. TYRA