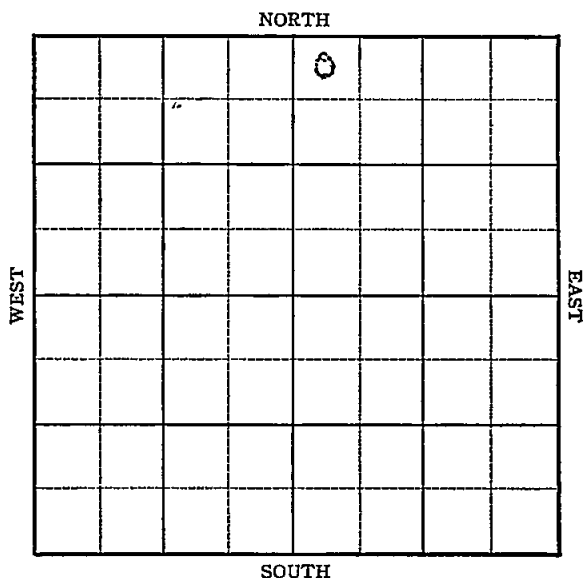


KANSAS

Russell


Section 10 Township 15 Range 13-WWell No. #1 MichelCompany M. B. Armer

Sec. 10 Twp. 15 R. 13WWell No. #1 Michel FarmM. B. Armer Company

Trapp

330 Ft. from N. Line Ft. from S. Line Ft. from E. Line330 Ft. from W. Line

NW NE

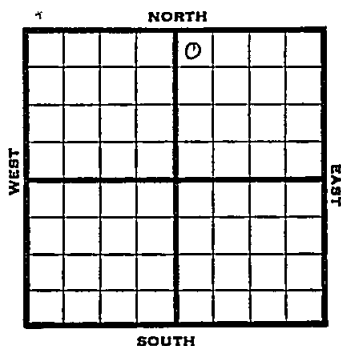

1946 Elev. 1880' REPORT

1/23 RUR
1/31 8" - 210' Anhy 850'
Drlg. 1570'
2/7 Drlg. 2934'
2/14 5" - 3370' T.D.
2/21 Lans. 3065' Drlg. 3085'
2/28 5" - 3370' T.D. 3370'
24 shots 3090-3104'
24 " 3138-74'
24 " 3234-42 500 acid.
S.S.O.

3/6 Arb. 3364
5" @ 3370
Perf. Water
TD 3370'

ABANDONED

KANSAS

Kansas Pool Name TrappMap No. 23 Sec. 10 Twp. 15 R. 13WWell No. 1 MichelM. B. Armer


Company

FIRST REPORT

Contractor

NW NE

SECTION PLAT

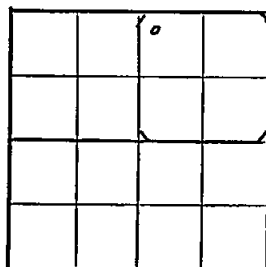330 Ft. from N. Line Ft. from S. Line Ft. from E. Line330 Ft. from W. LineRussell CountyLocation Rig up Drilling and Remarks:
RUR

RECORD

Cased in., ft.Sand Gas Oil Total Depth

PRODUCTION

1st 24 hrs. Nat. 1st 24 hrs. after shot Gas Cu. Ft.Dry Hole Abandoned

Date

JAN 23 1946 19S. I. LEWIS Scout

KANSAS Kansas Pool Name TrappMap No. 73 Sec. 10 Twp. 15 R. 13WWell No. 1 MichelM. B. Armer

Company

ABANDONED

Contractor

NW NE

E1, 1880
SECTION PLAT330

Ft. from N. Line

Ft. from S. Line

Ft. from E. Line

330

Ft. from W. Line

		0	

Russell County

Location

Rig up

Drilling and Remarks:

*Art 3364**5" C 3270**Prof. Water*

RECORD

Cased _____ in., _____ ft.

Sand _____

Gas _____

Oil _____

Total Depth *3270*

PRODUCTION

1st 24 hrs. Nat. _____

1st 24 hrs. after shot _____

Gas _____ Cu. Ft.

Dry Hole _____

Abandoned _____

Date

MAR 6 1946 19

S. J. LEWIS

Scout