

KANSAS

Barton

Section 29 Township 16 Range 12W

Well No. 2 Jacobs

Company Derby Drlg.

Laudick

NORTH

							0

WEST

EAST

SOUTH

1



Sec. 29 Twp. 16 R. 12W

Well No. #2. Jacobs Farm _____

Derby Drlg.

Company _____


Laudick Pool (Derby Drlg. Cont.)

_____ Ft. from N. Line

330' _____ Ft. from S. Line

330' _____ Ft. from E. Line

_____ Ft. from W. Line

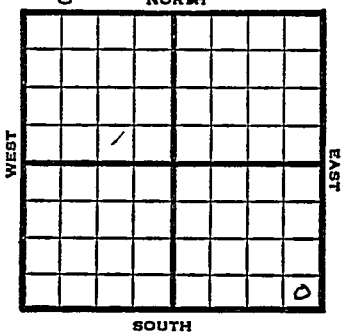

SE/C

1949 Elev 1882' REPORT

8/10 8" @ 188'
Anhy. 775'
Drlg. 1935'

8/17 Lansing 3091'
Arb. 3340'
5" @ 3341'
TD 3343'

8/24 500 Acids w & 103 bbls oil 4 hrs.
TD 3348.

8/31 " "

9/7 " "

9/14 TD 3348'
Arb. 3340'
5" @ 3341'
500 acid
Pump 75 Oil Pot
36° Gr
Comp

COMPLETED

Kansas

Map No. _____ Sec. 29 Twp. 16 R. 12W

Well No. 2 Jacobs

Derby drlg.

Company

Derby Drlg.

Contractor

SE/C

FIRST REPORT
SECTION FLAT

_____ Ft. from N. Line

330 Ft. from S. Line

330 Ft. from E. Line

_____ Ft. from W. Line

o

Barton County

RECORD

Location _____

Cased _____ in., _____ ft.

Rig up _____

Sand _____

Drilling and Remarks:

Gas _____

8" @ 188

Oil _____

Anny 775

Total Depth _____

drlg. 1935

PRODUCTION

1st 24 hrs. Nat. _____

1st 24 hrs. after shot _____

Gas _____ Cu. Ft.

Dry Hole _____

Abandoned _____

Date

AUG 10 1949 19

S. J. LEWIS Scout

Map No. K 55 Sec. 29 Twp. 16 R. 12W

Well No. 2 Jacobs

Derby Drlg. Company

COMPLETE

Contractor

SE/C

E. 1882
SECTION PLAT

 Ft. from N. Line

330 Ft. from S. Line

330 Ft. from E. Line

 Ft. from W. Line

Barton County

Location

Rig up

Drilling and Remarks:

Art 3340
5" @ 3341
500 acio
Prof. 75 in 100'

36 2/3

RECORD

Cased in., ft.

Sand

Gas

Oil

Total Depth 3348

PRODUCTION

1st 24 hrs. Nat.

1st 24 hrs. after shot

Gas Cu. Ft.

Dry Hole

Abandoned

Date

SEP 14 1949

S. J. LEWIS Scout