

DX 78-1


Barton

KANSAS

Section 29 Township 16 Range 12W

Well No. #1 Laudick

Company Frank G. Wood

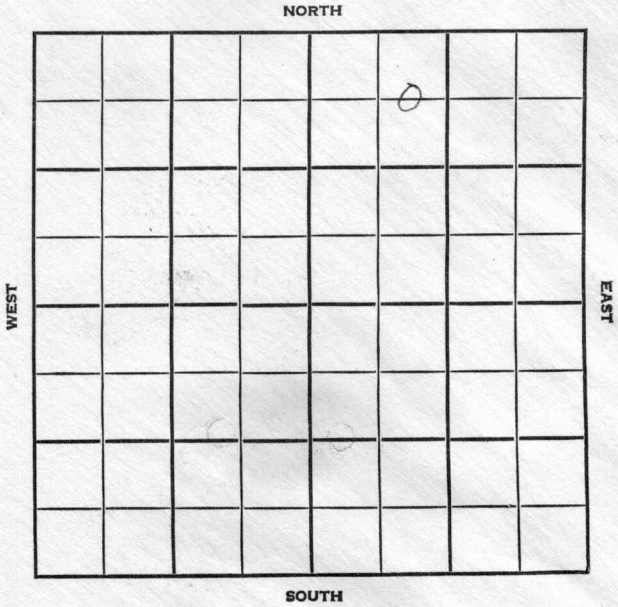


SEC. 29	TWP. 16	R. 12W
------------	------------	-----------

WELL NO. #1 Laudick FARM

COMPANY Frank G. Wood

CONTRACTOR S & W S. Beaver

_____ FT. FROM N. LINE
 _____ FT. FROM S. LINE
 _____ FT. FROM E. LINE
 _____ FT. FROM W. LINE

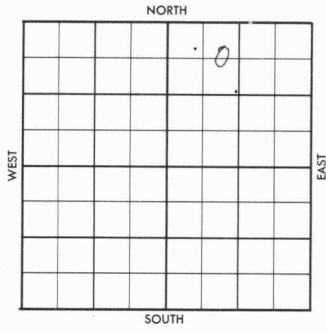

C E $\frac{1}{2}$ NW NE

1956	ELEVATION 1916'	REPORT
------	--------------------	--------

7-11 Comm. 7-8-56
 8" @ 322 w/185
 WOC

7-25 DST 3147-62 op 30 min. rec. 8' drlg.
 mud, BHP 0/15".
 DST 3259-66 op 30 min, rec. 15' SOCM,
 BHP 0/15".
 DST 3374-88 op 1 hr, rec. 60' OCM,
 BHP 525/20".
 DST 3388-3401 op 1 hr., rec. 300' wtr.
 oil / 185' oily wtr. / 120', 765/20".
 DST 3396-3401 op 1 hr. rec. 235' oily
 wtr. / 120 wty oil / 120' wtr.
 BHP 815/20"
 D & A
 Anh. 825'; H. 3023'; L. 3126';
 A. 3382';
 TD 3401'

ABANDONED

13

County Barton Elev. _____
 Sec. 29 Twp. 16 Rge. 12W
 Company Frank G. Wood
 Farm Name Laudick No. 1

Co.

TOPS	DEPTH	LOG	DATUM
Anh.			
Tp.			
H.			
Tr.			
Dg.			
Bl.			
L.			
K.C.			
B.K.C.			
Ce.			
C.			
M.			
M.			
K.			
Mz.			
Mq.			
V.			
S.			
S.			
A.			
R.			
Pe.			
G.			
T.D.			

Loc. in Sec. C E ¹/₂ NW NE

Geol. _____
 Contr. S & W

Pool S. Beaver

FIRST REPORT			
JUL 11 '56			

Lse.

No.

Sec.

T.

R.

Date Comm. 7-8-56
8" @ 322/185 WOC

JUL 11 1956

R. G.

County Barton Elev. 1916
 Sec. 29 Twp. 16 Rge. 12W
 Company Frank C. Wood
 Farm Name Laudick No. 1

Co.

TOPS	DEPTH	LOG	DATUM	Loc. in Sec.
Anh.	825			C E ¹ NW NE
Tr.				
H.	3023			
Tr.				
Dg.				
Bl.				
L.	3126			
K.C.				Geol.
B.K.C.				Contr.
Ce.				S & W
C.				
M.				Pool
M.				S. Beaver
K.				
Mz.				
Ma.				
V.				
S.				
S.				
A.	3382			ABANDONED JUL 25 1956
R.				
Pe.				
G.				
T.D.	3401			

Loc.

No.

Sec.

T.

R.

Date Comm. 7-8-56

8" @ 322/185 WOC JUL 18 '56 DST 3147

-62 30" rec 8' @ Md BHP

0/15 @ 3170 JUL 25 '56 DST 3259

-66 30" rec 15' 50CM BHP

0/15" DST 3374- 88 lhr 60'

OCM BHP 525/20" DST 3388-

3401 lhr rec 300' wtr oil + 185'

oil wtr + 120' wtr 765/20"

DST 3396-3401 lhr. rec 235' oil y

wtr + 120 wtr oil + 120' wtr BHP 815/20"