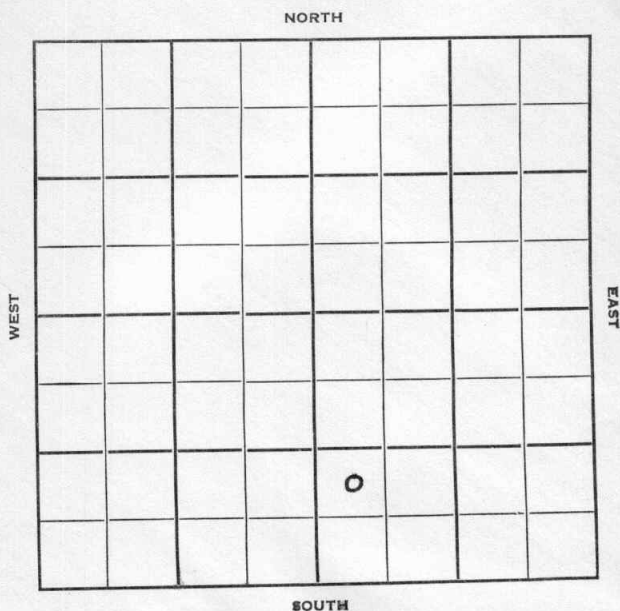


Section 10 Township 15 Range 13-WWell No. #2 Luerman "B"Company Keystone Petroleum

KANSAS

Russell

10

15

13-W

Sec. _____ Twp. _____ R. _____

Well No. #2 Luerman "B" Farm _____

Keystone Petroleum Company _____

Trapp Contractor _____


_____ Ft. from N. Line

990 Ft. from S. Line

_____ Ft. from E. Line

330 Ft. from W. Line

NW SW SE

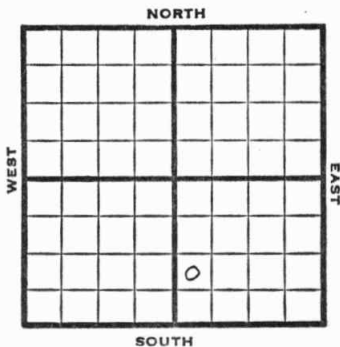

1950

Elev. 1842' REPORT

Location

Spud 12-12-50

Oil Well TD 2479

15" @ 350 13" @ 512

10" @ 790' Tarkio 2365'

6" @ 2470 TD 2479

Hydrofrac Comp. 144 bopd 15% wtr

COMPLETED

11/8
1951
2/14

County **Russell** State **Kansas**

Sec. 10 (Blk.) 15 (Sur.) 13W Map No.

Operator Keystone Petroleum

Well No. 2 Farm Luerman "B"

Elev.	Location	NW	SW	SE
-------	----------	----	----	----

0

County Russell State Kansas

Sec. 10 (Blk. Twp.) 15 (Sur. Rge.) 13W Map No.

Operator Keystone Petroleum

Well No. 2 Farm Luerman "B"

Elev.	1842	Location	NW	SW	SE
-------	------	----------	----	----	----


990 Ft. From S Line SE

330 Ft. From W Line Quarter

1st. Report

Completion FEB 14 1951

Remarks Trapp Pool

Spudding Date 12-12-50

Drq. Data	Oil well	TD 2479
-----------	----------	---------

15" @ 350 13" @ 512 10" @ 790

Tarkio 2365 6" @ 2470 TD 2479 Hydrofrac

Comp. 144 bopd 15% water

J. E. TYRA