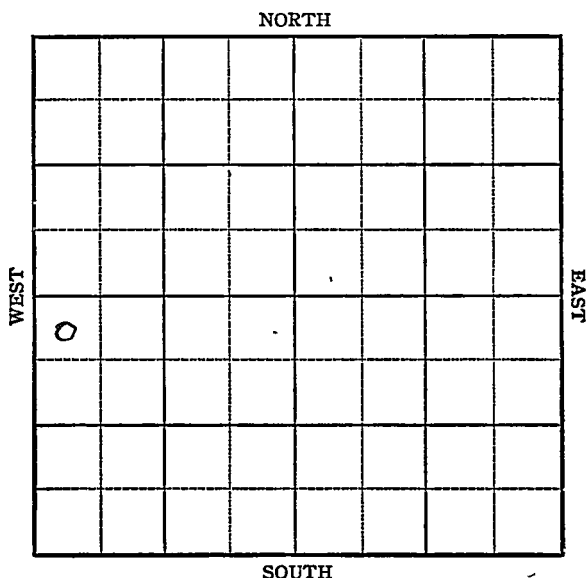


Section 30 Township 16 Range 12WWell No. #1 ReifCompany Mineral Prod.


KANSAS

Barton

Sec. 30 Twp. 16 R. 12-WWell No. #1 Reif Farm

Mineral Prod. Company

NORTH

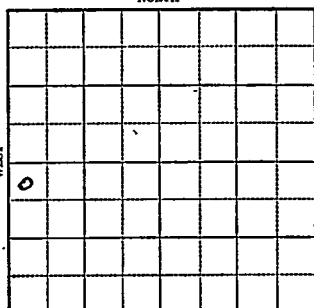330 Ft. from N. Line

Ft. from S. Line

Ft. from E. Line

330 Ft. from W. Line

Elev. 1935

SOUTH

1944

R E P O R T

2/2

10" @ 220
Anhy 853
Topeka 2703
Lans 3158
Arb 3382
TD 3403 Sat
5" @ 3400
Rust

2/8

"

2/15

Arb 3339 corrected
5" @ 3400

TD 3403
Swb 60 oil 1 hr.

2/23

5" @ 3400
Arb Corrected 3399

TD 3403
2000 acid
Pump 250 Pot.
Gravity 38

COMPLETED

Map No. KANSAS Sec. 30 Twp. 16 R. 12W

Well No. 1 Rein

Mineral Prod. _____ Company

FIRST REPORT _____ Contractor

NW SW


SECTION PLAT

330 Ft. from N. Line

_____ Ft. from S. Line

_____ Ft. from E. Line

330 Ft. from W. Line

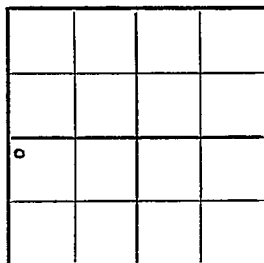

Wild cat

Location _____

Rig up _____

Drilling and Remarks:

10" - 220

Anhy. 853

Topeka 2703

Lans. 3158

Arb. 3382

TD 3403 Sat.

5" - 3400 Rust

RECORD

Cased _____ in., _____ ft.

Sand _____

Gas _____

Oil _____

Total Depth _____

PRODUCTION

1st 24 hrs. Nat. _____

1st 24 hrs. after shot _____

Gas _____ Cu. Ft.

Dry Hole _____

Abandoned _____

Date

FEB 2 1944 19

S. J. LEWIS Scout

Map No. KANSAS Sec. 30 Twp. 16 R. 12W

Well No. 1 Reif

Mineral Prod. Company

COMPLETED Contractor

NW SW


330 Ft. from N. Line

 Ft. from S. Line

 Ft. from E. Line

330 Ft. from W. Line

SECTION PLAT

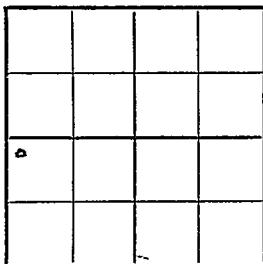

Reif

Location

Rig up

Drilling and Remarks:

Corr 3399 @ 2222 feet

5" @ 3400

2000 acid

Pump 250 B.Y.

2500 ft.

RECORD

Cased in., ft.

Sand

Gas

Oil

Total Depth 3403

PRODUCTION

1st 24 hrs. Nat.

1st 24 hrs. after shot

Gas Cu. Ft.

Dry Hole

Abandoned

Date

FEB. 23 1944 19 S. J. LEWIS Scout