

**KANSAS**

Ellis


Section 3 Township 12 Range 17W

Well No. 5 Miller

Company Westgate-Greenland

**Bemis**

NORTH

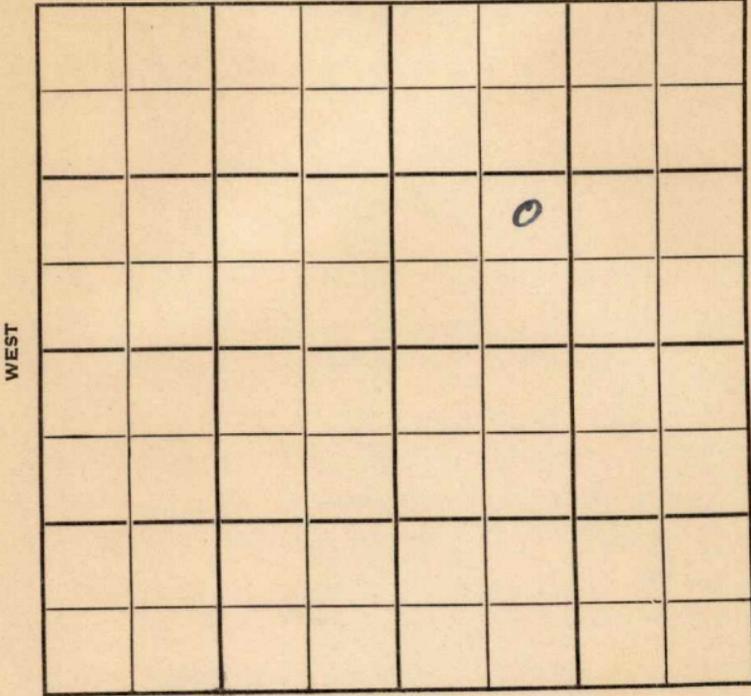

WEST

EAST

SOUTH

Sec. 3 Twp. 12 R. 17W

Well No. #5 Miller Farm

Westgate-Greenland Company


Bemis Pool (Jackson Drlg., Cont.)

\_\_\_\_\_ Ft. from N. Line

990' Ft. from S. Line

\_\_\_\_\_ Ft. from E. Line

990' Ft. from W. Line

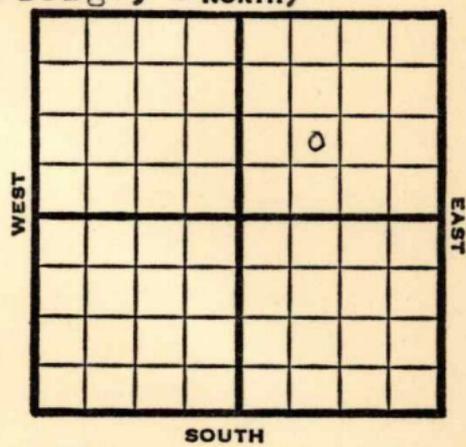

NE SW NE

1949	Elev. 2049' REPORT
10/19	8" @ 190' Drlg. 2500'
10/26	Lansing 3278' Simpson 3575' Drlg. 3610'
11/1	Arbuckle 3650' Granite Wash 4030' Granite 4050 TD 4050' 5" @ 3732'
11/9	"
11/16	"
11/23	"
11/29	"
12/7	"
12/14	"
12/21	"
12/28	"
1950	
1/11	TD 4052½ 8" @ 3732' Salt wtr disposal well Input 100 bbls salt wtr pr hr Aband Anhy 1260' Lan 3278' Cong 3540' Simp 3575' Arb. 3650' Granite wash 4030' Gr 4050' Aband.

**ABANDONED**

Map No. \_\_\_\_\_ Sec. 3 Twp. 12 R. 17W

Well No. 5 Miller

Westgate-Greenland Company

Jackson Drlg. Contractor

NE SW NE

FIRST REPORT  
SECTION PLAT

\_\_\_\_\_ Ft. from N. Line

990 Ft. from S. Line

\_\_\_\_\_ Ft. from E. Line

990 Ft. from W. Line

		o	

Ellis County

Location \_\_\_\_\_

Rig up \_\_\_\_\_

Drilling and Remarks:

8" @ 190

drlg. 2500

RECORD

Cased \_\_\_\_\_ in., \_\_\_\_\_ ft.

Sand \_\_\_\_\_

Gas \_\_\_\_\_

Oil \_\_\_\_\_

Total Depth \_\_\_\_\_

PRODUCTION

1st 24 hrs. Nat. \_\_\_\_\_

1st 24 hrs. after shot \_\_\_\_\_

Gas \_\_\_\_\_ Cu. Ft.

Dry Hole \_\_\_\_\_

Abandoned \_\_\_\_\_

Date

OCT 19 1949 19

S. J. LEWIS Scout

Map No. \_\_\_\_\_ Sec. 3 Twp. 12 R. 17W

Well No. 5 Miller

Westgate-Greenland

Company

Contractor

NE SW NE

*Feb. 20 1949*  
SECTION PLAT

\_\_\_\_\_ Ft. from N. Line

990 Ft. from S. Line

\_\_\_\_\_ Ft. from E. Line

990 Ft. from W. Line

		o	
ABANDONED			

Ellis County

Location \_\_\_\_\_

Rig up \_\_\_\_\_

Drilling and Remarks:

*8" @ 190*

*5" @ 3732*

*Salt Water*

*Disposal Well*

*Input 100 Bbls*

*Salt water per hr.*

Date

RECORD

Cased \_\_\_\_\_ in., \_\_\_\_\_ ft.

Sand \_\_\_\_\_

Gas \_\_\_\_\_

Oil \_\_\_\_\_

Total Depth 4052 1/2

PRODUCTION

1st 24 hrs. Nat. \_\_\_\_\_

1st 24 hrs. after shot \_\_\_\_\_

Gas \_\_\_\_\_ Cu. Ft.

Dry Hole \_\_\_\_\_

Abandoned \_\_\_\_\_

J. E. TYRA

JAN 11 1949

Scout

Date

.....	Misc.
.....	Pierce Map
.....	France Map
.....	Tracings
.....	Land Wall Map
.....	Land Small Map
.....	Scout Cards

JAN 16 1950

*Scott*

Drilling and Remarks:  
 Hg. up  
 Location

RECORD

Depth  
 Oil  
 Gas  
 Sand  
 Gravel

ABANDONED			

Br. 4050  
 Granite to Mark 4030  
 Crk 3650  
 Camp 3575  
 Camp 3540  
 Lam 3278  
 Crk 1260