

Section 10 Township 15 Range 13W

Well No. #1 Luerman "A"

Company Keystone Petr.



Russell KANSAS ✓

Sec. 10 Twp. 15 R. 13 W

Well No. # ²/₁ Luerman "A" Farm

Keystone Pet. Company

United Drlg. Contractor


Trapp Pool

_____ Ft. from N. Line

990 Ft. from S. Line

330 Ft. from E. Line

_____ Ft. from W. Line

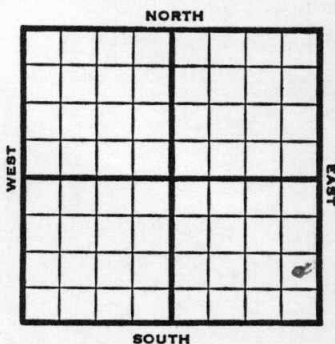

NE SE SE

1953

Elev. 1841' REPORT

9/2

Cellar & Pits

9/9

8" @ 205'

Anhy 790

Drlg. 1475'

9/16

Tarkio 2475', Heeb 2944

Drlg. 3026'

9/23

TD 3102', D&A

9/30

Spud 9-6-53 D & A TD 3338

8" @ 205' Anhy 790 Tarkio 2475

Heeb 2944 Br lime 3023 Lans 3040

Cong 3312 Arb. 3334 TD 3338

D & A

ABANDONED

Map No. _____ Sec. 10 Twp. 15 R. 13W

Well No. 2 Luerman "A"

Keystone Pet. Company

Contractor

CORRECTION

NE SE SE

SECTION PLAT

_____ Ft. from N. Line

990 Ft. from S. Line

330 Ft. from E. Line

_____ Ft. from W. Line

			0

Russell County

Location _____

Rig up _____

Drilling and Remarks:

Reported
#1 Luerman

RECORD

Cased _____ in., _____ ft.

Sand _____

Gas _____

Oil _____

Total Depth _____

PRODUCTION

1st 24 hrs. Nat. _____

1st 24 hrs. after shot _____

Gas _____ Cu. Ft.

Dry Hole _____

Abandoned _____

Date

SEP

9 1953

19

J. G. McGEHEE

Scout

