


Section 10 Township 15 Range 13W

Well No. #7 Anschutz

Company Sohio etal.

Trapp Pool NORTH

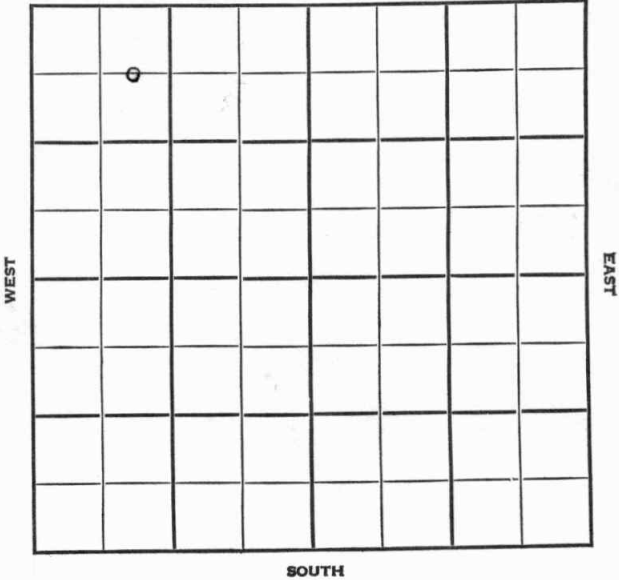

KANSAS

Russell

Sec. 10 Twp. 15 R. 13W

Well No. #7 Anschutz Farm

Sohio et al Company

Trapp Pool


660' Ft. from N. Line

Ft. from S. Line

Ft. from E. Line

990' Ft. from W. Line

C E L NW NW

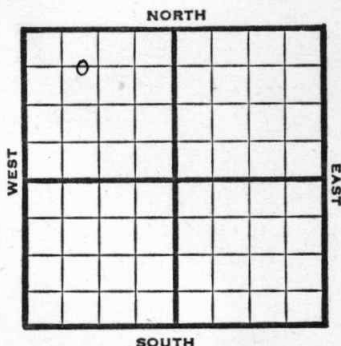

1948

Elev. 1858'

REPORT

3/24

RUR

3/31

8" @ 835

Drlg. 1440'

4/7

Lansing 3017'

Drlg. 3110'

4/14

Arbuckle 3313'

TD 3325'

5" @ 3317'

RUST

4/21

750 Acid swb 2 bbls oil PH & 2% W

4/28

"

5/5

"

5/12

Arb. 3313'

5" @ 3317'

Pump 37 oil / 19% W pot

40.9 Gr.

TD 33.25'

Comp.

COMPLETED

Map No. _____ Sec. 10 Twp. 15 R. 13W

Well No. 7 Anschutz

Sohio et al. Company

FIRST REPORT Contractor

C E L NW NW

SECTION PLAT

660 Ft. from N. Line

_____ Ft. from S. Line

_____ Ft. from E. Line

990 Ft. from W. Line

o			

Russell County

Location _____

Rig up _____

Drilling and Remarks:

R U R

RECORD

Cased _____ in., _____ ft.

Sand _____

Gas _____

Oil _____

Total Depth _____

PRODUCTION

1st 24 hrs. Nat. _____

1st 24 hrs. after shot _____

Gas _____ Cu. Ft.

Dry Hole _____

Abandoned _____

Date

MAR 24 1948 19

S. J. LEWIS Scout

Map No. 73 Sec. 10 Twp. 15 R. 13W

Well No. 7 Anschutz

Sohio etal. Company

COMPLETE

Contractor

E. 1858

C E L NW NW

SECTION PLAT

660 Ft. from N. Line

_____ Ft. from S. Line

_____ Ft. from E. Line

990 Ft. from W. Line

△			

Russell County

Location _____

Rig up _____

Drilling and Remarks:

Cr 3313

5" @ 3317

Pump 37 oil 7 19%

W 2 X

40 2 2

RECORD

Cased _____ in., _____ ft.

Sand _____

Gas _____

Oil _____

Total Depth 3325

PRODUCTION

1st 24 hrs. Nat. _____

1st 24 hrs. after shot _____

Gas _____ Cu. Ft.

Dry Hole _____

Abandoned _____

Date

MAY 12 1948

19

S. J. LEWIS Scout