


Section 23 Township 12 Range 14 W

Well No. # 1 Boxberger "F"

Company Trans-Era Pet.

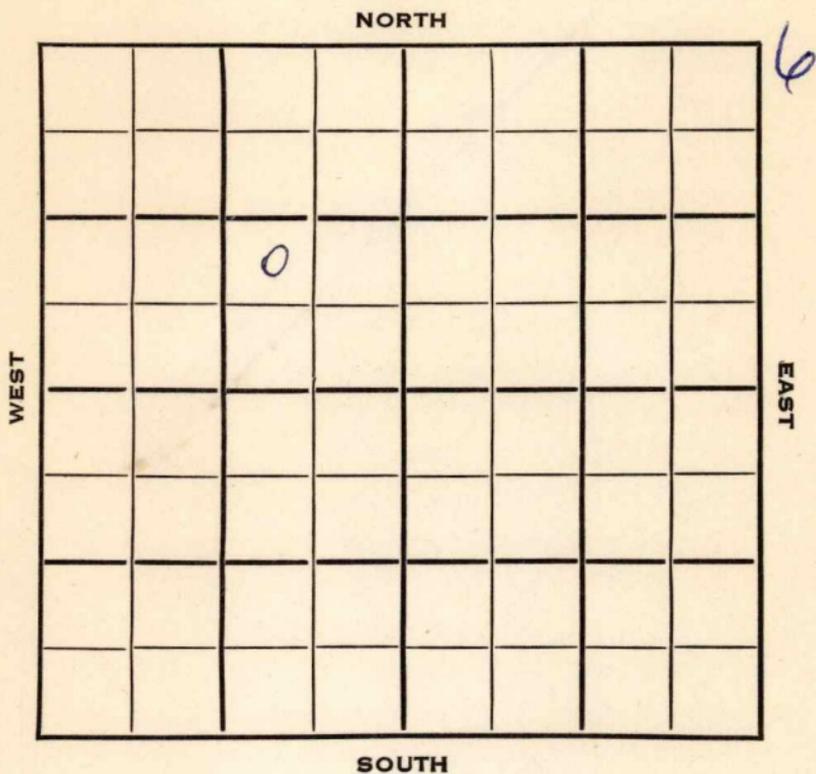

SEC.	TWP.	R.
23	12	14W ✓

WELL NO. 1 Boxberger "F" FARM

COMPANY Trans-Era Petr.

CONTRACTOR

Wildcat


Ft. from N. Line

990 Ft. from S. Line

990 Ft. from E. Line

Ft. from W. Line

NW SE NW

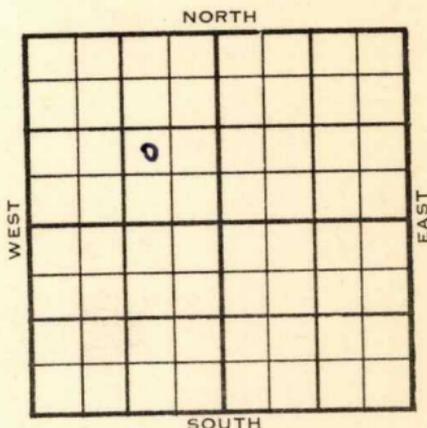

1954	ELEVATION 1755'	REPORT
------	--------------------	--------

5/12 Spud 5-7-54  
8" @ 183'  
Anhy 790'  
Drlg. 1490'

5/19 Spud 5-7-54 D & A TD 3321  
8" @ 183 Anhy 790 Top. 2665  
Heeb 2882 Tor. 2902 Lans 2933  
DST 2935-68 open 1 hr rec 6' mud O#  
DST 2977-85, open 1 hr rec 8' mud  
Arb. 3271 TD 3321 D & A

**ABANDONED**


County **Russell** State **Kansas**

Sec. **23** (Blk. Twp.) **12** (Sur. Rge.) **14W** Map No.

Operator **Trans-Era P. t.**

Well No. **1** Farm **Boxberger "F"**

Elev. Location **NW SE NW**

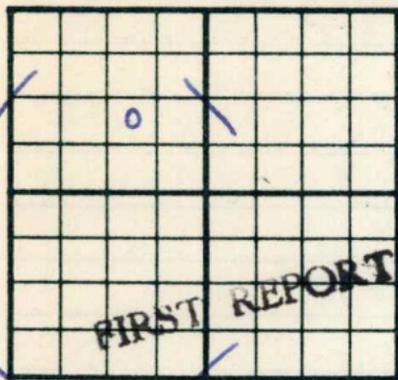

**990** Ft. From **S** Line **NW**

**990** Ft. From **E** Line Quarter

1st. Report **MAY 12 1954**

Completion

Remarks

Spudding Date **5-7-54**

Drlg. Data **Wildcat**

**8" @ 183 Anhy 790 drlg. 1490**


County Russell State Kansas

Sec. 23 (Blk. 12) (Sur. 14W) Map No.

Operator Trans-Era Pet.

Well No. 1 Farm Boxberger "F"

Elev. 1755 Location NW SE NW

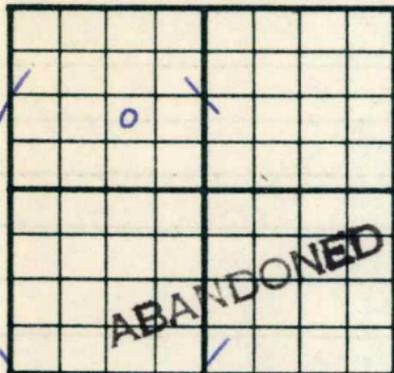

990 Ft. From S Line NW

990 Ft. From E Line Quarter

1st. Report

Completion MAY 19 1954

Remarks Wildcat

Spudding Date 5-7-54

Drilg. Data D & A TD 3321

8" @ 183 Anhy 790 Top. 2665

Heeb. 2882 Tor. 2902 Lans. 2933

DST 2935-68 open 1 hr. Rec. 6' mud O#

DST 2977-85 open 1 hr. Rec. 8' mud

Arb. 3271 TD 3321

D & A