


Section 26 Township 12 Range 14-W


Well No. #1 Funk

Company Gough Davie

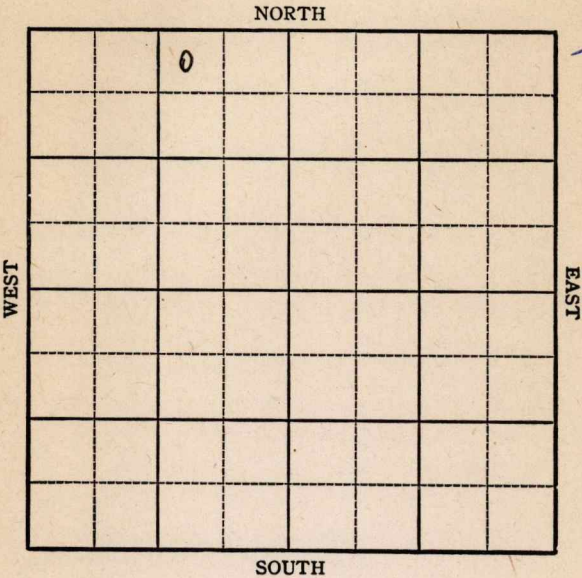

KANSAS

Russell

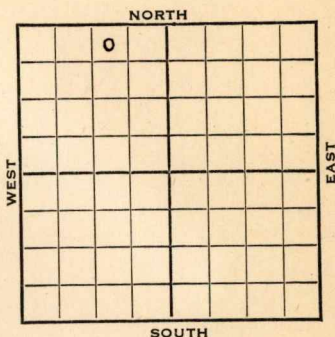Sec. 26 Twp. 12 R. 14-WWell No. #1 Funk FarmGough Davis Company330 Ft. from N. Line Ft. from S. Line990 Ft. from E. Line Ft. from W. Line

1943

Rev. 1776

REPORT

8/18	Cable Rig
8/25	" "
9/1	Spud
9/8	20" @ 31'
	15" @ 304
	12" @ 546
	Anhy 815
	10" @ 816
	Drlg. 1325'
9/15	Drlg. 2200'
9/22	Topeka 2646
	Drlg. 2656
9/29	Lans 2955
	7" @ 2965
	Drlg. 2997'
10/6	5" @ 3222'
	Cong 3247
	Arb 3332
	Drlg. 3347
	No shows

OVER

Russell

KANSAS

Map No. 72 Sec. 26 Twp. 12 R. 14W

Well No. 1 Funk

Gough Davis

Company

FIRST REPORT
NW NE NW

Contractor

SECTION PLAT

330 Ft. from N. Line

Ft. from S. Line

990 _____ Ft. from E. Line

Ft. from W. Line

Wildcat

	9		

Location

Rig up.

Drilling and Remarks:

Cable Rig

RECORD

Cased _____ in., _____ ft.

Sand

Gas _____

Oil _____

Total Depth _____

PRODUCTION

1st 24 hrs. Nat. _____

1st 24 hrs. after shot_____

Gas_____ Cu. Ft.

Dry Hole_____

Abandoned

Date _____

AUG 1 8 1943

19

S. J. LEWIS Scout

KANSASMap No. 72 Sec. 26 Twp. 12 R. 14WWell No. 1 FunkGough Davis

Company

ABANDONED

Contractor

NW NE NW

SECTION PLAT

330 Ft. from N. Line Ft. from S. Line990 Ft. from E. Line Ft. from W. Line

	o		

WildcatLocation Rig up

Drilling and Remarks:

Con. 93282V. 12 93296Cr. 83329

RECORD

Cased in., ft.Sand Gas Oil Total Depth 3297

PRODUCTION

1st 24 hrs. Nat. 1st 24 hrs. after shot Gas Cu. Ft.Dry Hole Abandoned

Date

OCT 13 1943 19S. J. LEWIS Scout