


Section 10 Township 15 Range 13W

Well No. #3 Luerman

Company Keystone Petroleum

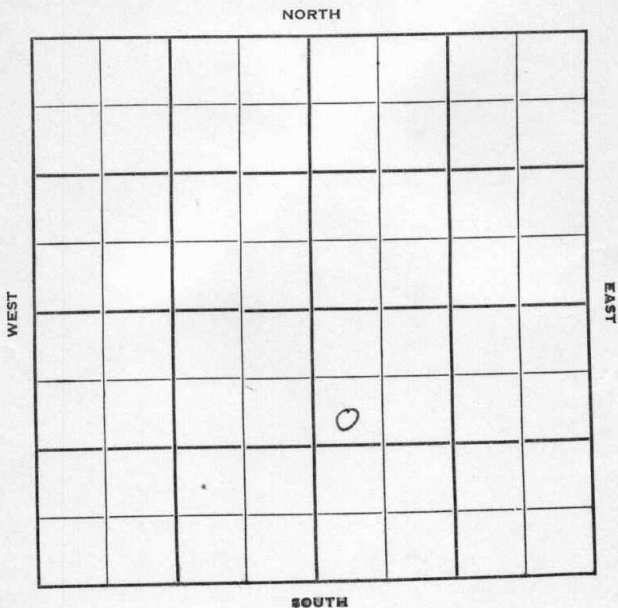

Russell

KANSAS

Sec. 10 Twp. 15 R. 13W

Well No. #3 Luerman Farm

Keystone Petroleum Company

Contractor

Trapp Pool


990 Ft. from N. Line

_____ Ft. from S. Line

_____ Ft. from E. Line

330 Ft. from W. Line

SW NW SE

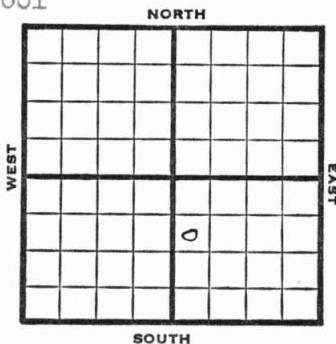

1951

Elev. 1849'

REPORT

10/24
1952
1/9

RUR

Spud 10-27-51

Oil well TD 3079' Anhy 795'
10" @ 805' 8" @ 2345' Top 2710'

Dodge 2955' 3 GOPH KC 3016'

TD 3079' FU 2090' oil 2½ hr.

5" @ 3074' CO to 3079' FU 1500'
oil 2 hr.

Comp. 55 BOPD

COMPLETED

County Russell State Kansas

Sec. 10 (Blk. Twp.) 15 (Sur. Rge.) 13W Map No.

Operator Keystone Petroleum

Well No. 3 Farm Luerman

Elev. 1849 Location SW NW SE

COMPLETE

990Ft. From N Line SE

330Ft. From W Line Quarter

1st. Report

Completion JAN 9 1952

Remarks Trapp Pool

Spudding Date 10-27-51

Drlg. Data Oil well TD 3079

Anhy 795 10" @ 805 8" @ 2345

Top. 2710 Dodge 2955 3 goph KC 3016

TD 3079 FU 2090' oil 2½ hr. 5" @ 3074

CO to 3079 FU 1500' oil 2 hr.

Comp. 55 bopd

J. E. TYRA