


KANSAS

Russell

Section 10 Township 15 Range 13-W

Well No. #1 Luerman

Company Keystone Pet.
Trapp Pool

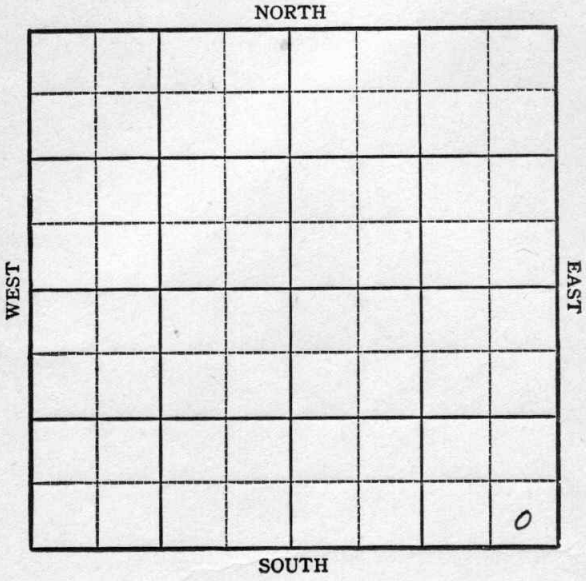

Russell KANSAS ✓

Sec. 10 Twp. 15 R. 13W

Well No. #1 Luerman Farm

Keystone Pet. Company


Trapp Pool

_____ Ft. from N. Line

330' Ft. from S. Line

330' Ft. from E. Line

_____ Ft. from W. Line

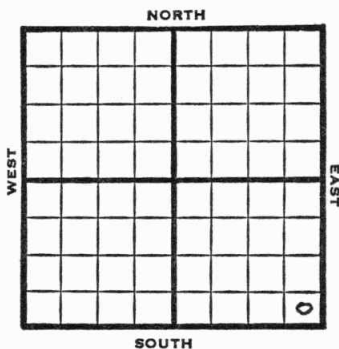

SE/C

1949

Elev 1813'

REPORT

11/30

Location

12/7

"

12/14

"

12/21

"

12/28

"

1950

4/26

TD 2473'

10"@ 200

8"@ 360

Anhy 762'

8"@ 775'

7" @ 2191'

Tarkno 2450'

Pay 2450-55

5"@ 2446

Comp 81 BOPD

Comp

COMPLETED

Map No. _____ Sec. 10 Twp. 15 R. 13W

Well No. 1 Luerman

Keystone Pet. Company

Contractor

SE/C

FIRST REPORT
SECTION PLAT

_____ Ft. from N. Line

330 Ft. from S. Line

330 Ft. from E. Line

_____ Ft. from W. Line

Russell County

Location X

Rig up _____

Drilling and Remarks:

RECORD

Cased _____ in., _____ ft.

Sand _____

Gas _____

Oil _____

Total Depth _____

PRODUCTION

1st 24 hrs. Nat. _____

1st 24 hrs. after shot _____

Gas _____ Cu. Ft.

Dry Hole _____

Abandoned _____

Date

NOV 30 1949

19

S. J. LEWIS

Scout

Map No. _____ Sec. 10 Twp. 15 R. 13W

Well No. 1 Luerman

Keystone Pet. Company

Contractor

SE/C

E. 1813

SECTION PLAT

_____ Ft. from N. Line

330 Ft. from S. Line

330 Ft. from E. Line

_____ Ft. from W. Line



Russell County

Location _____

Rig up _____

Drilling and Remarks:

10" c 200
 8" c 360
 anhy 762
 8" c 775
 7" c 2191
 2arkiv 2450
 Pay 2450-55
 5' c 2446

Comp. 81 high
Date _____

RECORD

Cased _____ in., _____ ft.

Sand _____

Gas _____

Oil _____

Total Depth 2473

PRODUCTION

1st 24 hrs. Nat. _____

1st 24 hrs. after shot _____

Gas _____ Cu. Ft.

Dry Hole _____

Abandoned _____

APR 26 1950

19

J. E. TYRA Scout