

KANSAS


Russell

FORM 51 5M 1-42 PETROL

Section 10 Township 15 Range 14-W

Well No. #2 Maier

Company Derby & Crow Drilling

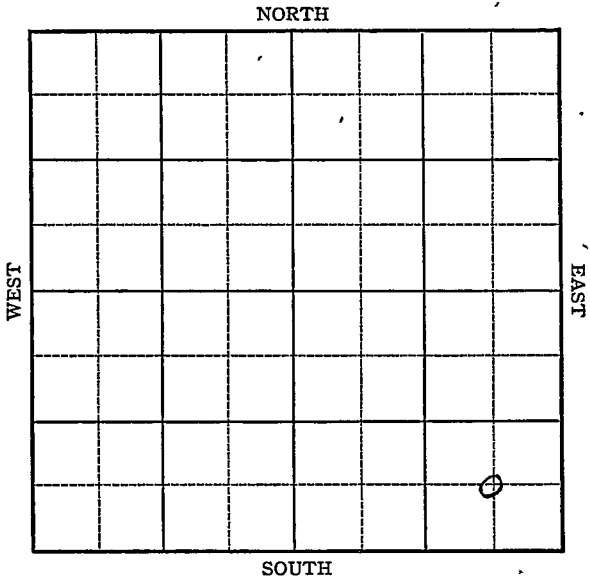

Sec. 10 Twp. 15 R. 14-W

Well No. #2 Maier Farm

Derby & Crow Drilling Company

Big Creek


 Ft. from N. Line

660 Ft. from S. Line

660 Ft. from E. Line

 Ft. from W. Line

900 1755

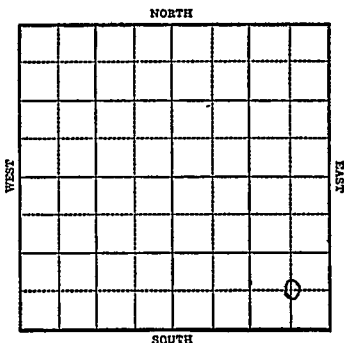

1943

R E P O R T

- 4/21 Location.
 - 4/28 "
 - 5/5 Rotary
 - 5/12 8" @ 624
Drlg. 2320'
 - 5/19 Topeka 2670
Lans 2965
Arb 3217-24 T.D. SO
5" @ 3218 RUST.
 - 5/26 T.D. 3228 $\frac{1}{2}$ -700' oil in 2 hrs.
Plug 3198 36 shots 3129-41 no
show 500 acid.
 - 6/2 Perf 60 shots 2964-3072 no show
Sq eeze off.
 - 6/9 Lans 2965
Arb. 3217
5" @ 3218'
Perf. Lans.
1500 gal. acid
T.D. 3228 $\frac{1}{2}$ '
Pump 77 Pot.
Gravity 32.7
- COMPLETED**

KANSAS

Russell

Map No. 73 Sec. 10 Twp. 15 R. 14WWell No. 2 MaierDerby & Crow Drilling CompanyFIRST REPORT Contractor

C S E S E

SECTION PLAT

 Ft. from N. Line660 Ft. from S. Line660 Ft. from E. Line Ft. from W. Line

			o

BIG CREEK POOL

Location XXXRig up

Drilling and Remarks:

RECORD

Cased in., ft.Sand Gas Oil Total Depth

PRODUCTION

1st 24 hrs. Nat. 1st 24 hrs. after shot Gas Cu. Ft.Dry Hole Abandoned

Date

APR 21 1943 1943

S. J. LEWIS

Scout

KANSAS Russell
 Map No. 73 Sec. 10 Twp. 15 R. 14W

Well No. 2 Maier

Derby & Crow Drilling Company

COMPLETED Contractor

C SE SE

SECTION PLAT

_____ Ft. from N. Line

660 Ft. from S. Line

660 Ft. from E. Line

_____ Ft. from W. Line

			o

BIG CREEK POOL

Location _____

Rig up _____

Drilling and Remarks:

Lans 2965
AY 3217
5' 03218
Prof. Lant.
1500 acid
Pump 77 P.S.

RECORD

Cased _____ in., _____ ft.

Sand _____

Gas _____

Oil _____

Total Depth 322 2/2

PRODUCTION:

1st 24 hrs. Nat. _____

1st 24 hrs. after shot _____

Gas _____ Cu. Ft.

Dry Hole _____

Abandoned _____

Date

322 2/2

JUN 9 1943 19

S. J. LEWIS Scott