


Section 10 Township 15 Range 13W

Well No. 5 Anschutz

Company Sohio

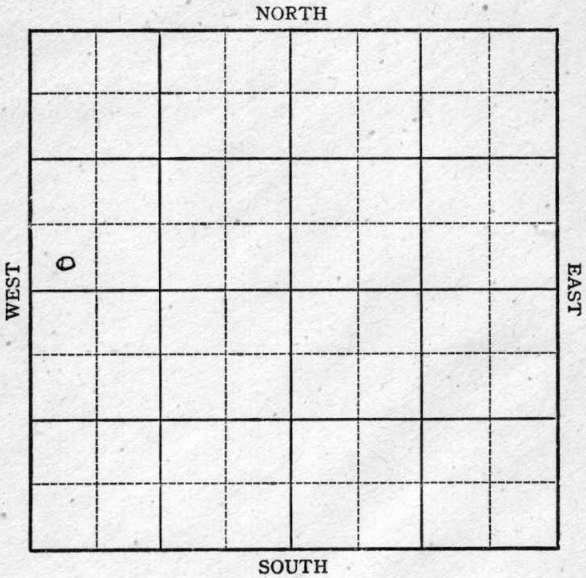

KANSAS

Russell

Sec. 10 Twp. 15 R. 13-W

Well No. #5 Anschultz Farm

Sohio Company

Trapp Pool


 Ft. from N. Line

330
~~660~~ Ft. from S. Line

 Ft. from E. Line

330 Ft. from W. Line

SW NW
~~C W L SW NW~~

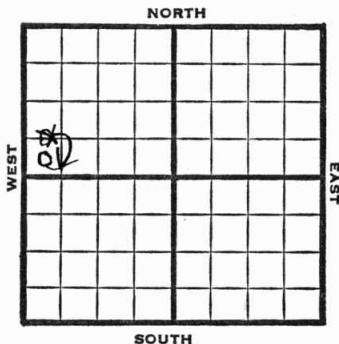

1947 Elev. 1875'

REPORT

4/16 Location

4/23 10" @ 832'
Drlg 1445'

4/29 Drlg 2910'

5/7 Arb 3329-35
TD 3335'
5" @ 3330
RUST

5/13 TD 3341'

5/20 " "

5/27 " "

6/4 Arb. 3329'
5" @ 3330'
Pump 33 oil and 22 water Pot
40.9 Gr.
TD 3341'

COMPLETED

Map No. 1573 Sec. 10 Twp. 15 R. 13W

Well No. 5 Anschultz

Sohio Company

FIRST REPORT Contractor

C W L SW NW

SECTION PLAT

 Ft. from N. Line

660 Ft. from S. Line

 Ft. from E. Line

330 Ft. from W. Line

o			

Russell County

Location X

Rig up

Drilling and Remarks:

RECORD

Cased in., ft.

Sand

Gas

Oil

Total Depth

PRODUCTION

1st 24 hrs. Nat.

1st 24 hrs. after shot

Gas Cu. Ft.

Dry Hole

Abandoned

Date

APR 16 1947 19

S. J. LEWIS Scout

Foot 10-46 Petrol
Kansas

Trapp Pool

Map No. _____ Sec. 10 Twp. 15 R. 13W

Well No. 5 Anschutz

Schio

Company

CORRECTION

Contractor

SW NW

SECTION PLAT

_____ Ft. from N. Line

330 Ft. from S. Line

_____ Ft. from E. Line

330 Ft. from W. Line

Russell County

Location _____

Rig up _____

Drilling and Remarks:

Reported

C W L SW NW

RECORD

Cased _____ in., _____ ft.

Sand _____

Gas _____

Oil _____

Total Depth _____

PRODUCTION

1st 24 hrs. Nat. _____

1st 24 hrs. after shot _____

Gas _____ Cu. Ft.

Dry Hole _____

Abandoned _____

Date

APR 23 1947 19

S. J. LEWIS Scout

Map No. 73 Sec. 10 Twp. 15 R. 13W

Well No. 5 Anschutz

Sohio Company

COMPLETE Contractor

SW SW NW

E 1, 1895
SECTION PLAT

 Ft. from N. Line

330 Ft. from S. Line

 Ft. from E. Line

330 Ft. from W. Line

Russell County

 Location

Rig up

Drilling and Remarks:

CR 43829
5" @ 330
Pump 38 oil +
2 water pad
40 2 1/2

RECORD

Cased in., ft.

Sand

Gas

Oil

Total Depth 334

PRODUCTION

1st 24 hrs. Nat.

1st 24 hrs. after shot

Gas Cu. Ft.

Dry Hole

Abandoned

Date

JUN 4 1947 19

S. J. LEWIS Scout