


Section 27 Township 12 Range 14W

Well No. #1 Claussen

Company Gough Davis

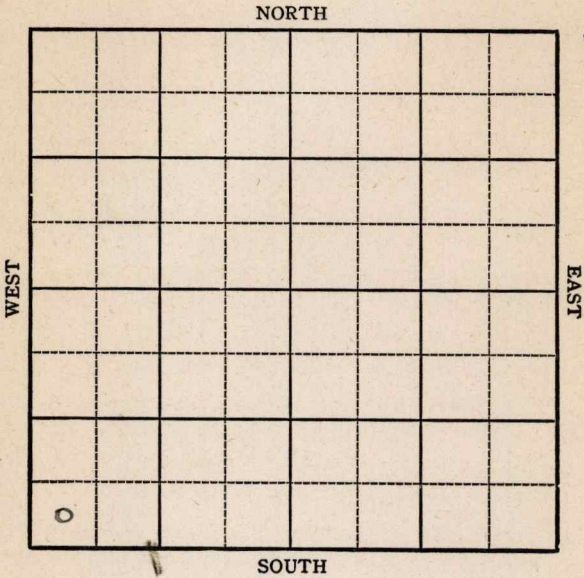

Sec. 27 Twp. 12 R. 14-W

Well No. #1 Claussen Farm

Gough Davis Company

SW/C


_____ Ft. from N. Line

330 Ft. from S. Line

_____ Ft. from E. Line

330 Ft. from W. Line

Elev. 1646

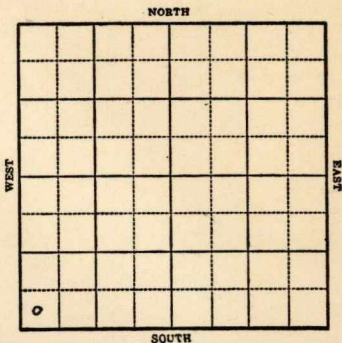

1944

R E P O R T

1-26 8" at 138'
Anhy 681'
1440' Drilling

2/2 **Howard 2460**
Drlg. 2480

2/8 **Topeka 2550**
ans 2816
Arb 3131

TD 3155
No shows
6" @ 3133

2/15 **Rust**
18 shots 2854-61
4000 acid 300 gluid
Testing.

2/23 "

3/1 Pump 55 oil & 25 water in 16 hrs.

3/7 " " "

3/16 " " " " " "

3/22 Pump 100 bluid 50% W.

3/29 " " "

4/5 " " "

4/12 " " "

4/19 " " "

4/26 " " "

5/3 " " "

OVER

1944

5/10 6" @ 3133

Abr 3131

Lans 2816

TD 3155

18 shots 22854-61

4000 acid

Pump 9 oil and 40 wtr.

Potential

Gravity 39

COMPLETED

Pool Name Claussen

KANSAS

Map No. 72 Sec. 27 Twp. 12 R. 14W

Well No. 1 Claussen

Gough Davis Company

COMPLETED Contractor

SW/C

SECTION PLAT

_____ Ft. from N. Line

330 Ft. from S. Line

_____ Ft. from E. Line

330 Ft. from W. Line

Russell County

RECORD

Location _____

Cased _____ in., _____ ft.

Rig up _____

Sand _____

Drilling and Remarks:

Gas _____

Oil & 3131

Oil _____

Lease 2816

Total Depth 3131

6" @ 3133

18' below 2854-61

4000 gal

Pump 9' oil + 40' water

Prod.

39 gal.

PRODUCTION

1st 24 hrs. Nat. _____

1st 24 hrs. after shot _____

Gas _____ Cu. Ft.

Dry Hole _____

Abandoned _____

Date

MAY 10 1944 19

S. J. LEWIS Scout