

Russell

KANSAS

Section 29 Township 12 Range 14WWell No. #1 FosterCompany Crown Oil

NORTH Wildcat

							0

WEST EAST

SOUTH

8

KANSAS Russell

Sec. 29 Twp. 12 R. 14W

Well No. #1 Foster Farm

Crown Oil Company


Wildcat

Ft. from N. Line

330' Ft. from S. Line

330' Ft. from E. Line

Ft. from W. Line

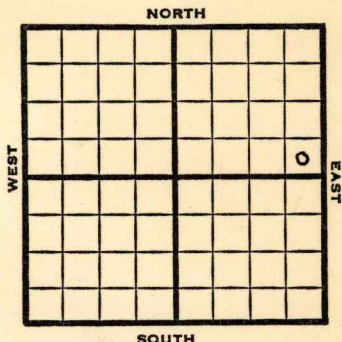

SE NE

1949 Elev 1624' REPORT

9/14 Location

9/21 Drlg. 2190'

9/28 Lansing 2804'

TD 2853

5"@ 2841'

10/5 TD 2854

3500 acid

Swb 350 bbls oil aday

10/12 "

10/19 "

10/26 "

11/1 "

11/9 "

11/16 "

11/23 Pump 7 bbls oil / 5 W aday

11/29 "

12/7 "

12/14 "

12/21 TD 2854'

Lansing 2804'

5"@ 2841'

3000 acid

Pump 12 Oil / 15 W Pot

39° Gr.

Comp

COMPLETED

Kansas

Map No. _____ Sec. 29 Twp. 12 R. 14WWell No. 1 Foster

Crown Oil

Company

Contractor


SE NE

SECTION PLAT

_____ Ft. from N. Line

330 Ft. from S. Line330 Ft. from E. Line

_____ Ft. from W. Line

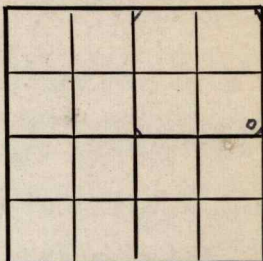

Russell County

RECORD

Location X

Rig up _____

Drilling and Remarks:

Cased _____ in., _____ ft.

Sand _____

Gas _____

Oil _____

Total Depth _____

PRODUCTION

1st 24 hrs. Nat. _____

1st 24 hrs. after shot _____

Gas _____ Cu. Ft.

Dry Hole _____

Abandoned _____

Date

SEP 14 1949

19

S. J. LEWIS

Scout

Kansas

Map No. _____ Sec. 29 Twp. 12 R. 14W

Well No. 1 Foster


Crown Oil

Company

COMPLETE

Contractor

SE NE

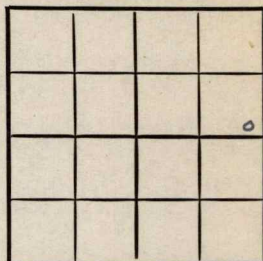E. 1624.
SECTION PLAT

Ft. from N. Line

330

Ft. from S. Line

330

Ft. from E. Line

Ft. from W. Line

Russell County

Location _____

Rig up _____

Drilling and Remarks:

Lease 2804

5" 2841

3000 acid

Pump 12 oil 751000

392-82

RECORD

Cased _____ in., _____ ft.

Sand _____

Gas _____

Oil _____

Total Depth 2804

PRODUCTION

1st 24 hrs. Nat. _____

1st 24 hrs. after shot _____

Gas _____ Cu. Ft.

Dry Hole _____

Abandoned _____

Date

DEC 21 1949

19

S. J. LEWIS

Scout