

Cowley

Kansas

FORM 51 25M 3-49 PETROL

25


33

O.W.D.D 3E

Section Cowley Township _____ Range _____

Well No. #1 Hunt

Company L.C. Smitheiman
~~S. A. Sampson et al~~

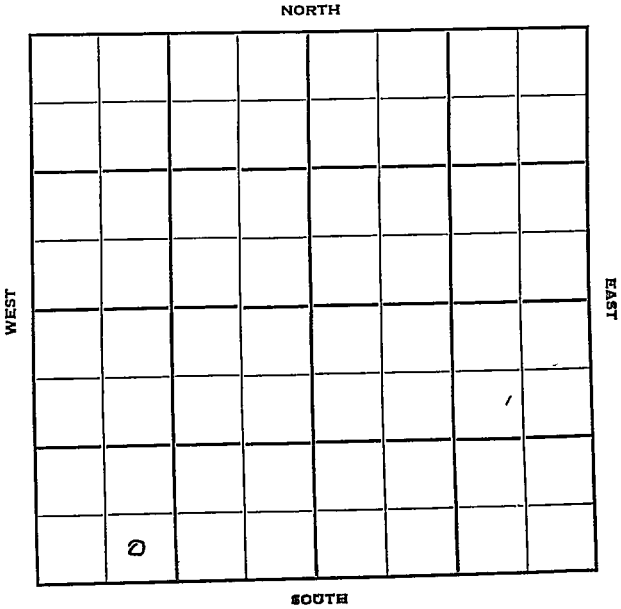

Sec. 25 Twp. 33 R. 3E

Well No. #1 Hunt Farm

L. C. Smitherman
S. A. Sampson et al Company

Uhl - Contr. Contractor
Willcat


_____ Ft. from N. Line

330' Ft. from S. Line

_____ Ft. from E. Line

990' Ft. from W. Line

SE SW SW

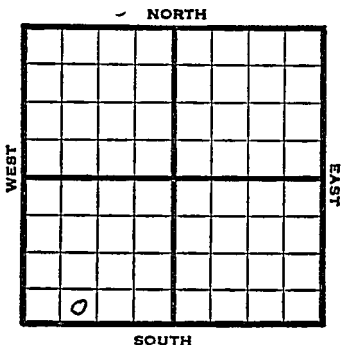

1951 Elev. ^{1161'} ~~1156'~~ REPORT

11/14 Spud 11-3-51
8" @ 96'
Drlg. 2270'

11/28 Spud 11-3-51
D&A TD 3320
8" @ 96'
Top 1440 Lans. 2108
Stal. 2133 Layton 2563
KC 2755 BKC 2875
Ft. Scott 2950 Bart 3257
Miss 3319 TD 3320
D&A **ABANDONED**

O.W.D.D

1953

7/14 Bart 3257', Miss 3319'
OTD 3319'
DD to test Arb.

9/2

D & A
TD 3368'
Bart 3257, Miss 3319
OTD 3319
5" @ 3368
CO to 3276 perf 48/ 3270-72 Hydro.
D & A

ABANDONED

