

KANSAS


FORM 51 5M 1-42 PETROL

Russell

Section 10 Township 15 Range 14-W

Well No. #2 Maier

Company Ohio Oil

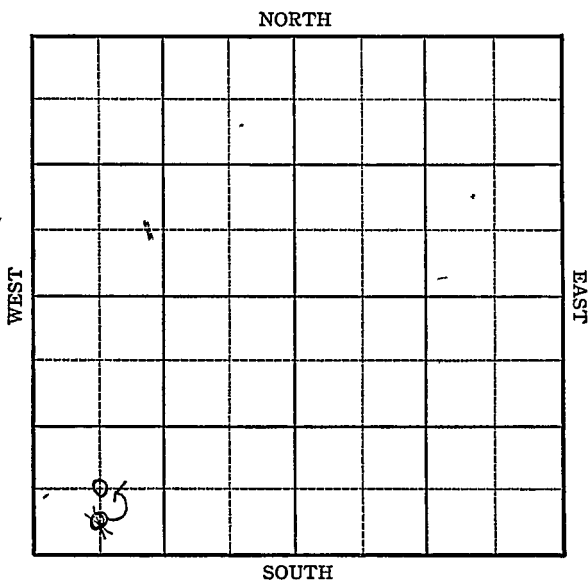

KANSAS

Russell

Sec. 10 Twp. 15 R. 14 ~~W~~

Well No. #2 Maier Farm

Ohio Oil Company

Big Creek

 Ft. from N. Line


660

330 Ft. from S. Line

 Ft. from E. Line

660 Ft. from W. Line

Elev. 1775

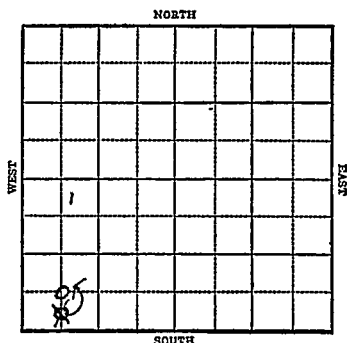

1943	R E P O R T
7/21	Location.
7/28	Derrick
8/4	10" @ 780'-790' WOC.
8/11	Topeka 2682 Drig. 2975'
8/18	Lans 2975 Arb 3226 7" @ 3227 T.D. 3228 SO Rust
8/25	Arb 3226 7" @ 3227 1000 acid Pump 499 Pot. T.D. 3235' Gravity 32.7
	COMPLETED

KANSAS

Map No. 73 Sec. 10 Twp. 15 R. 14WWell No. 2 MaierOhio Oil

Company

~~FIRST REPORT~~

Contractor


SECTION PLAT

C S L SW SW
Ft. from N. Line330 Ft. from S. Line

Ft. from E. Line

660 Ft. from W. Line

BIG CREEK POOL

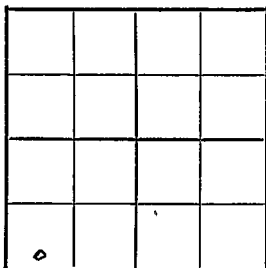Location X

Rig up

Drilling and Remarks:

RECORD

Cased in., ft.Sand Gas Oil Total Depth

PRODUCTION

1st 24 hrs. Nat. 1st 24 hrs. after shot Gas Cu. Ft.Dry Hole Abandoned

Date

JUL 21 1943

19.

S. J. LEWIS Scout

KANSAS 3
 Map No. 3 Sec. 10 Twp. 15 R. 14W

Well No. 2 Maier

Ohio Oil

Company

CORRECTION

Contractor

C SW SW


SECTION PLAT

 Ft. from N. Line

660 Ft. from S. Line

 Ft. from E. Line

660 Ft. from W. Line

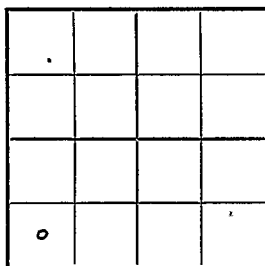

Big Creek Pool

Location

Rig up

Drilling and Remarks:

Reported

C S L SW SW

RECORD

Cased in., ft.

Sand

Gas

Oil

Total Depth

PRODUCTION

1st 24 hrs. Nat.

1st 24 hrs. after shot

Gas Cu. Ft.

Dry Hole

Abandoned

Date

JUL 21 1943

19

S. J. LEWIS

Scout

KANSAS

Map No. 73 Sec. 10 Twp. 15 R. 14WWell No. 2 Maier

Ohio Oil

Company

COMPLETED

Contractor

C SW SW

SECTION PLAT

_____ Ft. from N. Line

660 Ft. from S. Line

_____ Ft. from E. Line

660 Ft. from W. Line

Big Creek Pool

0			

Location _____

Rig up _____

Drilling and Remarks:

*Cr 3226**7" @ 3227**1000 acid**Pump 499 P.D.**3226*

RECORD

Cased _____ in., _____ ft.

Sand _____

Gas _____

Oil _____

Total Depth *3228.5*

PRODUCTION

1st 24 hrs. Nat. _____

1st 24 hrs. after shot _____

Gas _____ Cu. Ft. ;

Dry Hole _____

Abandoned _____

Date

AUG 25 1943

19

S. J. LEWIS Scout