


Russell

KANSAS

Section 35 Township 12 Range 14W

Well No. #1 R. McCormick

Company C. E. Liggett

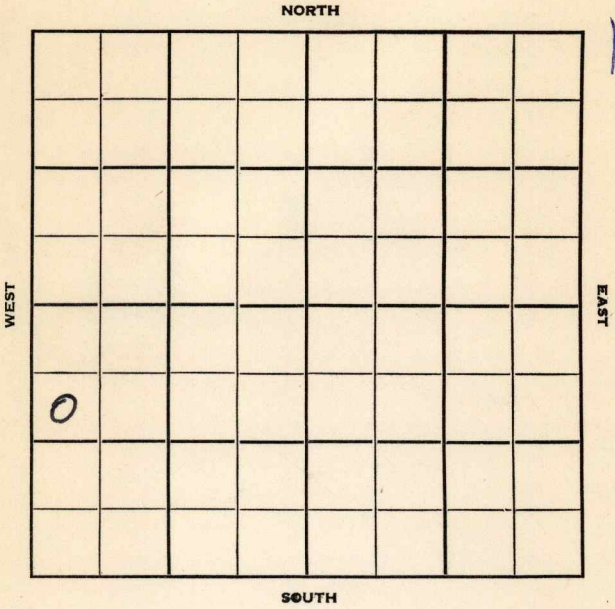

Russell

KANSAS

Sec. 35 Twp. 12 R. 14 W

Well No. # 1 R. McCormick Farm

C. E. Liggett Company

Wakefield. Contractor

Wildcat


990 Ft. from N. Line

Ft. from S. Line

Ft. from E. Line

330 Ft. from W. Line


SW NW SW

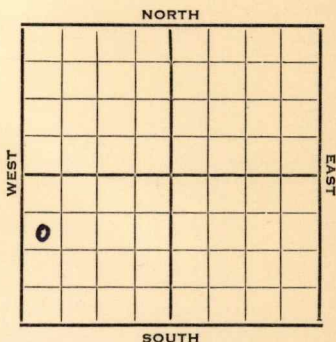

1952 Elev. 1580' REPORT

7/2 Cellar & Pits
7/9 Drlg. 200
7/17 15" @ 107 12" @ 305
10" @ 611
Anhy 643 Drlg. 960
7/23 Drlg. 1810'
7/30 Drlg. 2375'
8/6 8" @ 2205' Topeka 2495 Dodge 2734
7" @ 2750' SSO 2790
Drlg. 2843'
8/13 Spud 7-6-52
D&A TD 2990'
15" @ 107' 12" @ 305 10" @ 611'
Anhy 643 8" @ 2205 Top. 2495
Dodge 2734 7" @ 2750' SSO 2790
Lans. 2746 TD 2990 D&A

ABANDONED

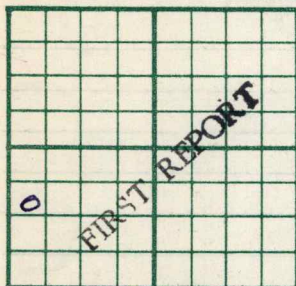County **Russell** State **Kansas**Sec. **35** (Blk.) **12** (Sur.) **14W** Map No.Operator **C. E. Liggett**Well No. **1** Farm **R. McCormick**Elev. Location **SW NW SW****990** Ft. From **N** Line **SW****330** Ft. From **W** Line Quarter1st. Report **JUL 2 1952**

Completion

Remarks

Wakefield-Contr.

Spudding Date

Drlg. Data

Wildcat**Cellar & pits****J. G. McGEHEE**

County Russell State Kansas
 Sec. 35 (Blk. 12 (Sur. 14W Map No.
 (Twp. (Rge.)
 Operator C. E. Liggett
 Well No. 1 Farm R. McCormick
 Elev. 1580 Location SW NW SW



990 Ft. From N Line SW
330 Ft. From W Line Quarter

1st. Report

Completion AUG 13 1952

Remarks Wildcat

Wakefield - Contr.

Spudding Date 7-6-52

Drlg. Data D & A TD 2990

15" @ 107 12" @ 305 10" @ 611

Anhy 643 8" @ 2205 Top. 2495

Dodge 2734 7" @ 2750 SSO 2790

Lens. 2746 TD 2990

D & A

J. G. McGEHEE