


Section 35 Township 12 Range 14W

Well No. #1 Woelk

Company Taxman Oil Co.

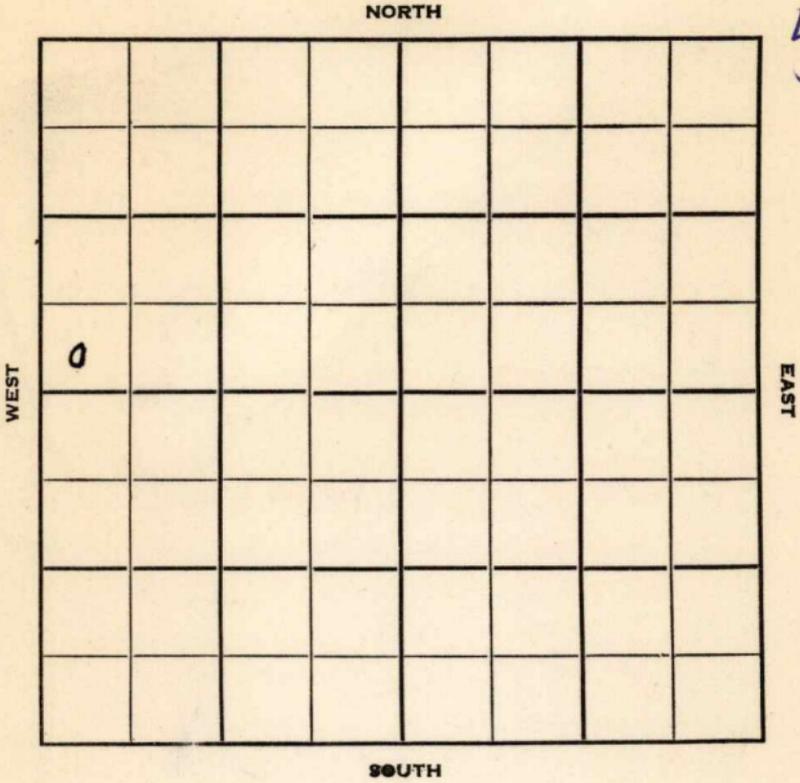

Sec. 35 Twp. 12 R. 14W

Well No. #1 Woelk Farm

Taxman Oil Co. Company

V. D. Sidey - Contr. Contractor


\_\_\_\_\_ Ft. from N. Line

330' Ft. from S. Line

\_\_\_\_\_ Ft. from E. Line

330' Ft. from W. Line

SW SW NW

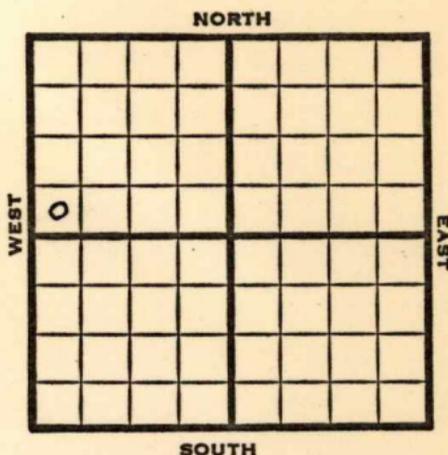

1951

**Elev. 1586'**

REPORT

6/6

Spud 5-25-51

8" @ 185

Drlg. 2803'

6/20

Spd 5-25-51

D&A TD 2820

8" @ 185

Top 2461 Heeb. 2706

Dodge 2724 Lans. 2758

DST 2760-90 opn 52 min.

Rec. 640' mud & wtr

TD 2820 D&A

**ABANDONED**



County Russell State Kansas

Sec. 35 (Blk. 12 (Sur. 14W (Twp.) (Rge.) Map No.

Operator Taxman Oil Co.

Well No. 1 Farm Woelk

Elev. 1586 Location SW SW NW


330 Ft. From S Line NW

330 Ft. From W Line Quarter

1st. Report

Completion JUN 20 1951

Remarks

V. D. Sidey - Contr.

Spudding Date 5-25-51

Drlg. Data D & A TD 2820

8" @ 185 Top. 2461 Heeb. 2706

Dodge 2724 Lans. 2758 DST 2760-90

open 52 min. Rec. 640' mud & water

TD 2820 D & A