

Russell

KANSAS

FORM 51 25M 3-49 PETROL

Section 35 Township 12 Range 14W

Well No. #2 McCormick

Company Prairie Oil Well Drlg.

NORTH

WEST

EAST

8							

SOUTH

12

Russell

KANSAS

Sec. 35 Twp. 12 R. 14W

Well No. #2 McCormick Farm

Prairie Oil Well Plug

Miscellaneous (Zimmerman, Contr.) Company


330' Ft. from N. Line

_____ Ft. from S. Line

_____ Ft. from E. Line

330' Ft. from W. Line

NW SW

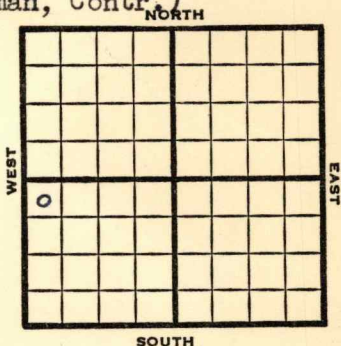

1949

REPORT

11/23 Machine

11/29 Spud

12/7 15" @ 70'

10" @ 300'

Drlg 595'

12/14 8" @ 606'

Drlg. 1465'

12/21 Drlg 2200'

12/28 7" @ 2215'

Drlg 2230'

1950

3/15

TD 3035'

15" @ 70'

10" @ 300'

8" @ 606'

5" @ 2778'

Cong 3005'

D&A

Aband.

ABANDONED

Map No. _____ Sec. 35 Twp. 12 R. 14W

Well No. 2 McCormick

Prairie Oil Well Drlg. Company

Zimmerman Contractor

NW SW

FIRST REPORT
SECTION PLAT

330 Ft. from N. Line

_____ Ft. from S. Line

_____ Ft. from E. Line

330 Ft. from W. Line

o			

Russell County

Location _____

Rig up _____

Drilling and Remarks:

Machine _____

RECORD

Cased _____ in., _____ ft.

Sand _____

Gas _____

Oil _____

Total Depth _____

PRODUCTION

1st 24 hrs. Nat. _____

1st 24 hrs. after shot _____

Gas _____ Cu. Ft.

Dry Hole _____

Abandoned _____

Date

NOV 23 1949 19

S. J. LEWIS Scout

Kansas

Miscellaneous

Map No. _____ Sec. 35 Twp. 12 R. 14WWell No. 2 McCormick

_____ Prairie Oil Well Drlg. _____ Company

_____ Contractor

NW SW

SECTION PLAT

330 Ft. from N. Line

_____ Ft. from S. Line

_____ Ft. from E. Line

330 Ft. from W. Line

ABANDONED			
0			

Russell County

Location _____

Rig up _____

Drilling and Remarks:

15" @ 70

10" @ 300

8" @ 606

5" @ 2778

Cong 3005

D & A

RECORD

Cased _____ in., _____ ft.

Sand _____

Gas _____

Oil _____

Total Depth 3035

PRODUCTION

1st 24 hrs. Nat. _____

1st 24 hrs. after shot _____

Gas _____ Cu. Ft.

Dry Hole _____

Abandoned _____

Date

MAR 15 1950

19

J. E. TYRA Scout