


Russell

KANSAS

Section 36 Township 12 Range 14-W

Well No. 1 Reinhardt

Company R. E. Hess et al

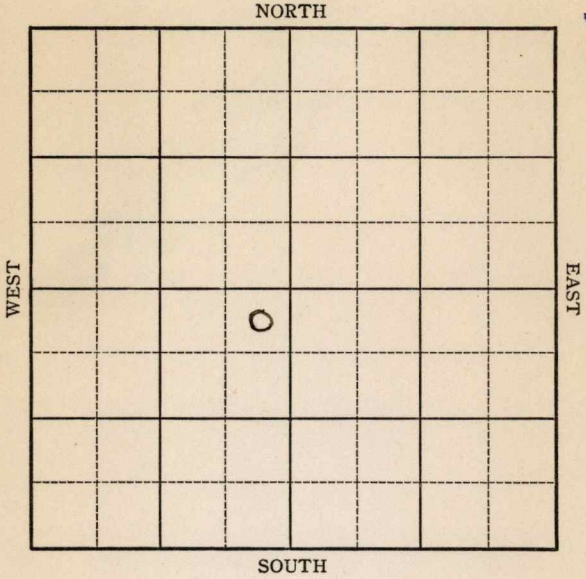

Sec. 36 Twp. 12 R. 14-W


Well No. #1 Reinhardt Farm
R. E. Hess et al Company

330 Ft. from N. Line

_____ Ft. from S. Line

330 Ft. from E. Line

_____ Ft. from W. Line

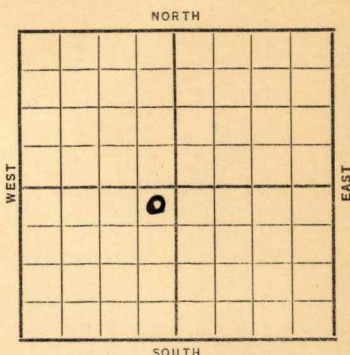

Elev. 1595'

Date	REPORT
1938	
1/5	Location
1/14	15" @ 150'. Drlg. 215'.
1/20	Drlg. 420'.
1/28	12" @ 275'. Anhy 498'
	10" @ 600' Drlg. 1460'
2/3	Fort Riley 1530' Florence Flint 1630'
	Drlg. 1800'
2/11	8" @ 2232'. Topeka 2505'?
	Drlg. 2780'.
2/18	K.C. 2784'? 6" @ 2790'.
	Sm. S.O. Shut down.
2/26	8" @ 2790'.
	K.C. 2787' (Corrected)
	Drlg. 2950'.
3/4	Cong. 3085'. Simp. sand 3130'.
	Arb. 3135? T.D. 3140'. No shows.
	Cementing cave.
	OVER

1938

3/9

Simp. sand 3113'.

~~TX~~ Arb. 3140'.

T.D. 3165' (Corrected)

1000' water at 3155-65'.

ABANDONED

Russell **KANSAS**

Map No. 72 Sec. 36 Twp. 12 R. 14W

Well No. 1 Reinhardt

R. E. Hess etal Company

Contractor

FIRST REPORT

NE SW

330 Ft. from N. Line

_____ Ft. from S. Line

330 Ft. from E. Line

_____ Ft. from W. Line

SECTION PLAT

	0		

Location X

Rig up _____

Drilling and Remarks:

RECORD

Cased _____ in., _____ ft.

Sand _____

Gas _____

Oil _____

Total Depth _____

PRODUCTION

1st 24 hrs. Nat. _____

1st 24 hrs. after shot _____

Gas _____ Cu. Ft.

Dry Hole _____

Abandoned _____

Date

JAN 5 - 1938 19

H. D. Hatfield Scout

Russell

KANSAS

Map No. 72 Sec. 36 Twp. 12 R. 14W

Well No. Reinhardt

R. E. Hess etal Company

Contractor

ABANDONED

SECTION PLAT

NE SW

330 Ft. from N. Line

_____ Ft. from S. Line

330 Ft. from E. Line

_____ Ft. from W. Line

	0		

Location _____

Rig up _____

Drilling and Remarks:

*Simp sand 3113
(corrected)*

Arb 3140

1000' wtr

3155-65'

DVA

RECORD

Cased Simp sand 3113 in 3113 ft.

Sand Arb 3140

Gas _____

Oil _____

Total Depth 3165

PRODUCTION

1st 24 hrs. Nat. _____

1st 24 hrs. after shot _____

Gas _____ Cu. Ft.

Dry Hole _____

Abandoned _____

Date

MAR 9 - 1938

H. D. Hatfield Scout