

Section 35 Township 12S Range 14W

Well No. #1 McCormack

Company Paririe Oil Well Drlg.

NORTH

				0			

SOUTH

WEST

EAST

15

KANSAS

Russell

Sec. 35 Twp. 12 R. 14-W

Well No. #1 McCormick Farm

Prairie Oil Well Drlg Company

Wildcat

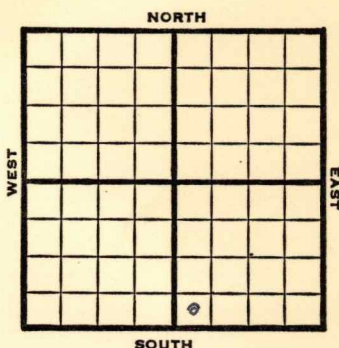
Ft. from N. Line

330 Ft. from S. Line

Ft. from E. Line

330 Ft. from W. Line

SW SE



1949

Elev. 1579' REPORT

10/5 12" @ 58'
10" @ 355'
Drlg 580'
10/12 8" @ 602'
Drlg 1315'
10/19 Drlg 1875'
10/26 Tarkio 2230'
TD 2300'
Run 6"
11/1 Topeka 2445'
Lansing 2753'
Drlg. 2820'
11/9 5" @ 2880'
Drlg. 2970'
11/16 TD 3072' in Cong.
Cong 3045'
Aband.

ABANDONED

Kansas

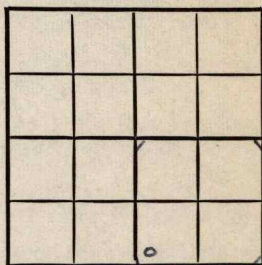
Wildcat

Map No. _____ Sec. 35 Twp. 12 R. 14WWell No. 1 McCormick

_____ Prairie Oil Well Drlg. _____ Company

_____ Contractor

SW SE

FIRST REPORT
SECTION PLAT

_____ Ft. from N. Line

330 Ft. from S. Line

_____ Ft. from E. Line

330 Ft. from W. Line

Russell County

Location _____

Rig up _____

Drilling and Remarks:

12" @ 58

10" @ 355

drlg. 580

RECORD

Cased _____ in., _____ ft.

Sand _____

Gas _____

Oil _____

Total Depth _____

PRODUCTION

1st 24 hrs. Nat. _____

1st 24 hrs. after shot _____

Gas _____ Cu. Ft.

Dry Hole _____

Abandoned _____

Date

OCT 5 1949

19

S. J. LEWIS

Scout

Kansas

Wildcat

Map No. _____ Sec. 35 Twp. 12 R. 14WWell No. 1 McCormick

Prairie Oil Well Drlg. _____ Company

ABANDONED

Contractor

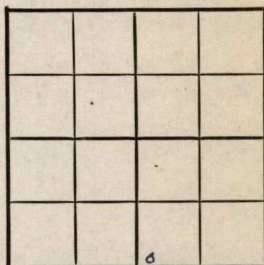
SW SE

E. 1579
SECTION PLAT

_____ Ft. from N. Line

330 Ft. from S. Line

_____ Ft. from E. Line

330 Ft. from W. Line

Russell County

Location _____

Rig up _____

Drilling and Remarks:

Cong 3045

RECORD

Cased _____ in., _____ ft.

Sand _____

Gas _____

Oil _____

Total Depth 3072 in Cong

PRODUCTION

1st 24 hrs. Nat. _____

1st 24 hrs. after shot _____

Gas _____ Cu. Ft.

Dry Hole _____

Abandoned _____

Date

NOV 16 1949

19

S. J. LEWIS Scout