
FORM 51 25M 3-49 PETROL

KANSAS Russell

Section 2 Township 12 Range 15-W

Well No. #1 Shaffer

Company Anschutz Drlg

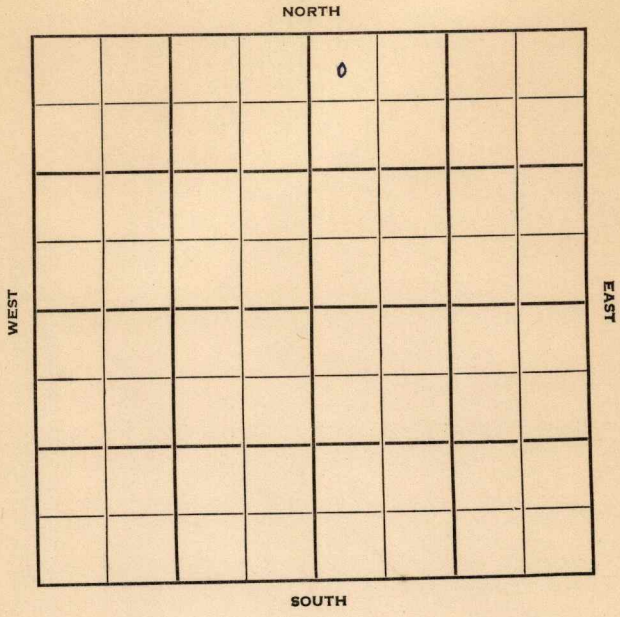

FORM 252-A
5M 10-48 PETROL

Russell KANSAS

Sec. 2 Twp. 12 R. 15W

Well No. #1 Shaffer Farm

Anschutz Drlg. Company

Eulert Pool


330' Ft. from N. Line

_____ Ft. from S. Line

_____ Ft. from E. Line

330' Ft. from W. Line

NW NW NE

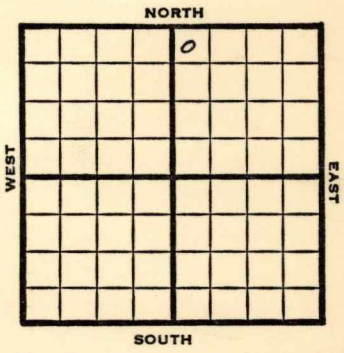

1950	Elev. 1815' REPORT
1/11	Cellar & Pits
1/25	8" @ 874' Topeka 2672' Heeb 2924' Lovington 2945' Lans. 2975' Arb 3308' D&A TD 3336'

ABANDONED

Form 26 200 Bks. 6-49 Petrol

Kansas

Eulert Pool

Map No. _____ Sec. 2 Twp. 12 R. 15W


Well No. 1 Shaffer

Anschutz Drlg. Company

Contractor

NW NW NE

SECTION PLAT

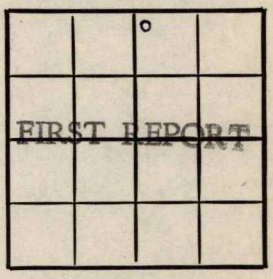

330 Ft. from N. Line

Ft. from S. Line

Ft. from E. Line

330 Ft. from W. Line

Russell County

Location

Rig up

Drilling and Remarks:

Cellar & Pits

RECORD

Cased in., ft.

Sand

Gas

Oil

Total Depth

PRODUCTION

1st 24 hrs. Nat.

1st 24 hrs. after shot

Gas Cu. Ft.

Dry Hole

Abandoned

Date

JAN 11 1950 19

J. E. TYRA Scout

Form 26 200 Bks. 11-49 Petrol

Eulert Pool

Kansas

Map No. ____ Sec. 2 Twp. 12 R. 15W

Well No. 1 Shaffer

Anschutz Company

Contractor

NW NW NE

El. 1815

SECTION PLAT



330 Ft. from N. Line

____ Ft. from S. Line

____ Ft. from E. Line

330 Ft. from W. Line

Russell County

Location

Rig up

Drilling and Remarks:

8" @ 874.

Topeka 2672
Heb 2924
Lovington 2945
Lans 2975
Arb 3308

RECORD

Cased ____ in., ____ ft.

Sand

Gas

Oil

Total Depth 3336

PRODUCTION

1st 24 hrs. Nat.

1st 24 hrs. after shot

Gas ____ Cu. Ft.

Dry Hole

Abandoned

D & A.

Date

JAN 25 1950 19

J. E. TYRA Scout