

KANSAS

Russell


Form 51-5M-7-39-Palace

Section 8 Township 15 Range 13-W

Well No. #2 Geo. Reins

Company Gulf

NORTH **Coralena Pool**

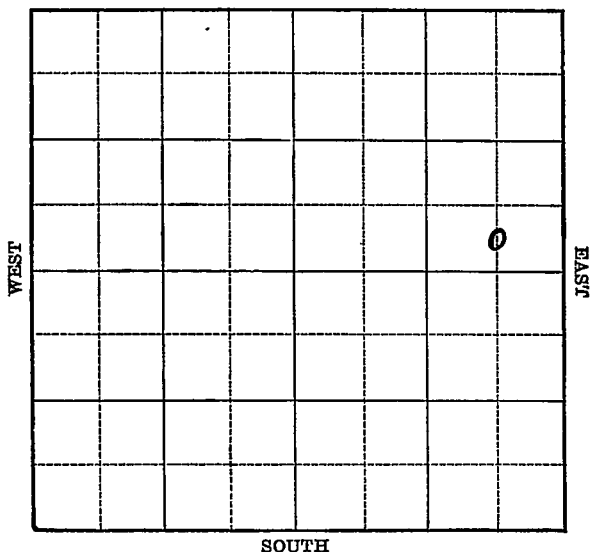

Sec. 8 Twp. 15 R. 13-W

Well No. #2 Geo. Reins Farm

Gulf Company

(Coralena)


_____ Ft. from N. Line

330 Ft. from S. Line

660 Ft. from E. Line

_____ Ft. from W. Line

Elev. 1863

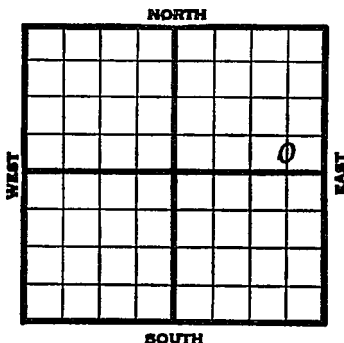

1940	REPORT
3/6	Rotary Derrick.
3/14	8" - 467' WOC.
3/21	Drlg. 2670'
3/28	Arb. 3337' Drlg. 3340'
4/4	SD 3340'
4/12	" "
4/18	20 shots 3046-50' Trace oil.
4/24	Arb. 3337'
	5" - 3118'
	T.D. 3343'
	44 shots 3046-64'
	4000 acid.
	15 bbls. oil.
	COMPLETED

Map No. 73 Sec. 8 Twp. 15 R. 13WWell No. 2 Geo. ReinsGulf Company

Contractor

FIRST REPORT**C S $\frac{1}{2}$ SE NE****SECTION PLAT**

			o

 Ft. from N. Line330 Ft. from S. Line660 Ft. from E. Line Ft. from W. Line**CORALENA POOL**Location Rig up Drilling and Remarks: **Rotary derrick****RECORD**Cased in., ft.Sand Gas Oil Total Depth **PRODUCTION**1st 24 hrs. Nat. 1st 24 hrs. after shot Gas Cu. Ft.Dry Hole Abandoned

Date

MAR 6 1940 .19

S. J. LEWIS

Scout

Map No. 73 Sec. 8 Twp. 15 R. 13WWell No. 2 Geo. ReinGulf Company

Contractor

COMPLETED**SECTION PLAT**C S $\frac{1}{2}$ SE NE Ft. from N. Line330 Ft. from S. Line660 Ft. from E. Line Ft. from W. Line

CORALENA POOL

Location Rig up

Drilling and Remarks:

*C₂ & 3337**3" C 3118**44 Shot to 3046-64**4000 acid**1574 h.***RECORD**Cased in., ft.Sand Gas Oil Total Depth 3343**PRODUCTION**1st 24 hrs. Nat. 1st 24 hrs. after shot Gas Cu. Ft.Dry Hole Abandoned

Date

APR 24 1940 19S. J. LEWIS Scout