


Section 28 Township 33 Range 3 E

Well No. # 1 Borheit (*Barhite*)

Company Drillers Prod.

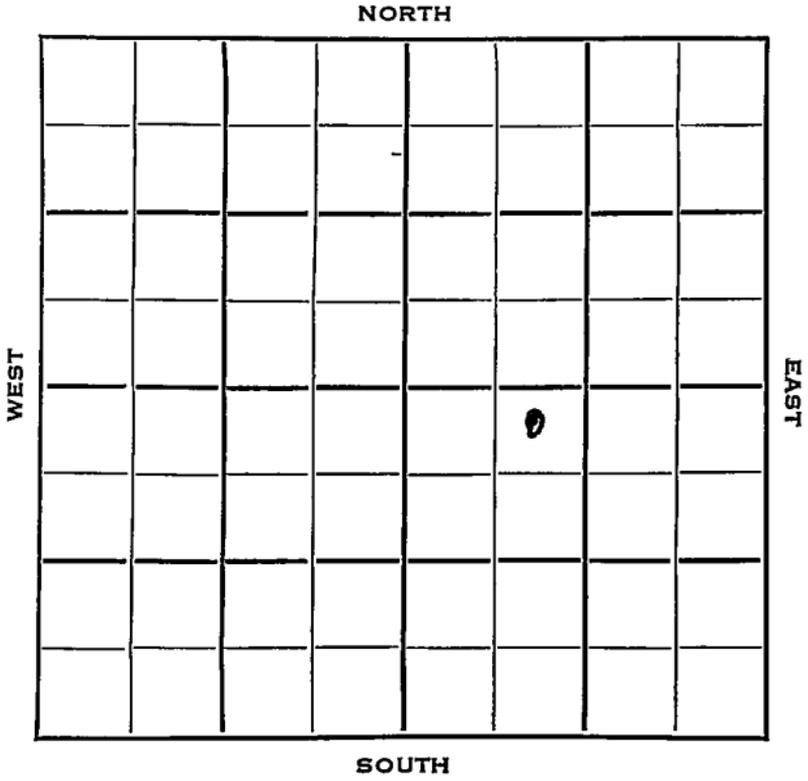

Sec. 28 Twp. 33 R. 3 E

Well No. # 1 Borheit Farm

Drillers Prod. Company

Drillers Prod. Contractor


Gueda Springs Pool NORTH

330 Ft. from N. Line

_____ Ft. from S. Line

_____ Ft. from E. Line

990 Ft. from W. Line

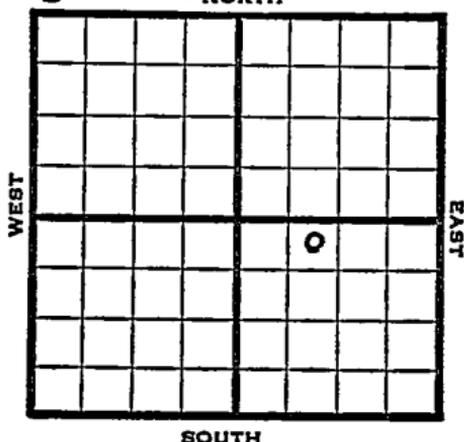

NE NW SE

1953

Elev. 1119' REPORT

5/13

Location

6/24

Spud 5-15-53

D&A

TD 3333

8" @ 96

Lans 2176, Layton 2621, KC 2810, B KC 2923, Marm 3000, Cherokee 3116, Bart 3292

TD 3331

5" @ 3330

Miss 3331

DD 3333

20/3307-12, 28/3314-21

Hydro.

S/14 bwph, 71/3292-99, 26/3292-99,

17/3306-12, 28/3307-13, 500A

S/66 gw 6 goph

D&A

ABANDONED

County **Cowley** State **Kansas**

Sec. **28** (Blk. Twp.) **33** (Sur. Rge.) **3E** Map No.

Operator **Drillers Prod.**

Well No. **1** Farm **Borheit**

Elev. Location **NE NW SE**

330 Ft. From **N** Line **SE**

990 Ft. From **W** Line Quarter

Ist. Report **MAY 13 1953**

Completion

Remarks

Drillers Prod. - Contr.

Spudding Date

Drig. Data **Gueda Springs Pool**

Location
