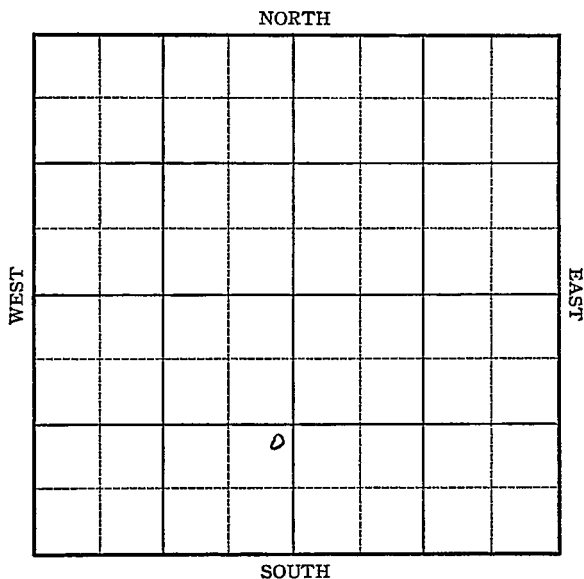


Russell

KANSAS

Section 8 Township 15 Range 13-WWell No. 8 -DetrickCompany Carter Oil

Russell KANSAS

Map No. _____ Sec. 8 Twp. 15 R. 13W

Well No. 8-Detrick

Carter Oil Company

Contractor

FIRST REPORT
NE SE SW

SECTION PLAT

	0		

_____ Ft. from N. Line

990 Ft. from S. Line

330 Ft. from E. Line

_____ Ft. from W. Line

Location _____

Rig up _____

Drilling and Remarks:

BRR

RECORD

Cased _____ in., _____ ft.

Sand _____

Gas _____

Oil _____

Total Depth _____

PRODUCTION

1st 24 hrs. Nat. _____

1st 24 hrs. after shot _____

Gas _____ Cu. Ft.

Dry Hole _____

Abandoned _____

Date

SEP 29 1920 19 H. D. Hatfield Scout

Russell

KANSAS

Map No. _____ Sec. 8 Twp. 15 R. 13WWell No. 8-Detrick

Carter Oil

Company

Contractor

COMPLETED

NE SE SW

_____ Ft. from N. Line

990

_____ Ft. from S. Line

330

_____ Ft. from E. Line

_____ Ft. from W. Line

SECTION PLAT

	0		

Location _____

Rig up _____

Drilling and Remarks:

1500 Acid

POT 1944

RECORD

Cased 6 in., 3168 ft.Sand 511 3168

Gas _____

Oil _____

Total Depth 3174

PRODUCTION

1st 24 hrs. Nat. _____

1st 24 hrs. after shot _____

Gas _____ Cu. Ft.

Dry Hole _____

Abandoned _____

Date

NOV 3 1937 19

H. D. Hatfield Scout